

1776

24

8.0

7.6

Errol  
Schnider

1786

1785

1.5

1787

37.3

John

29.1

1788

John

TRUJILLO

ONAGHY

DOVER LN.

0.9

5.2

13.3

10.7

10.4

0.3

**RECEIVED**

APR 25 1984




WATER RESOURCES DEPT  
SALEM, OREGON

#2 Changed Ownership to three (3) Tracts

T-5475

Take out 3.7 ac from each & flip-flop

TRANSFER FROM

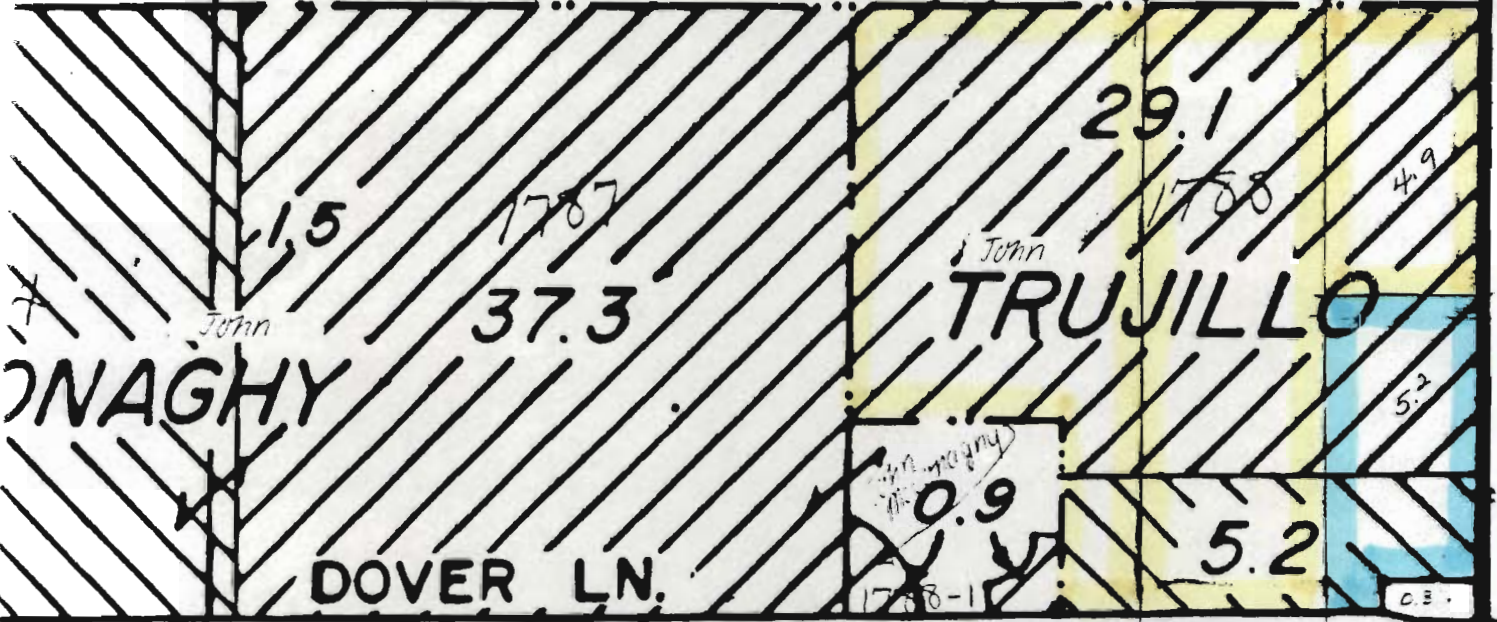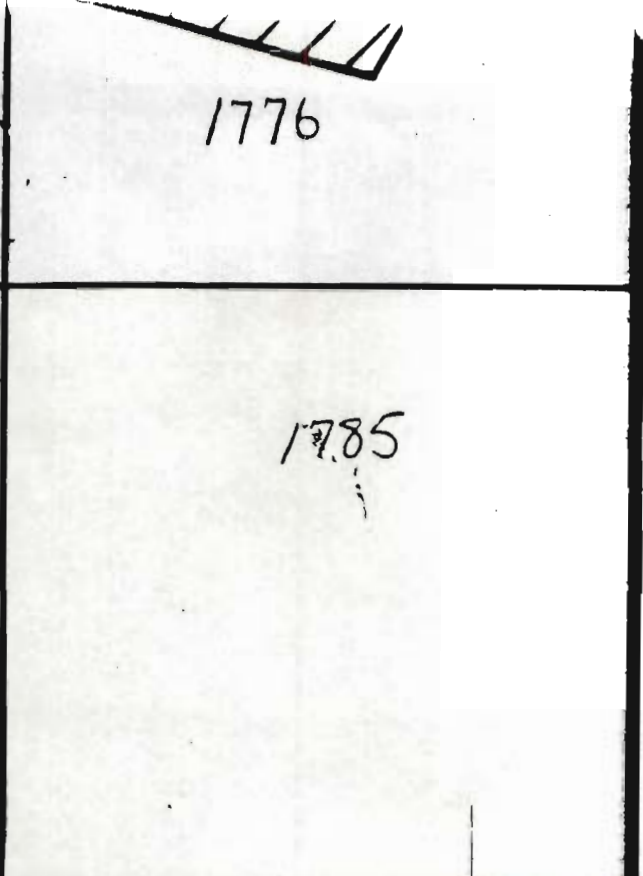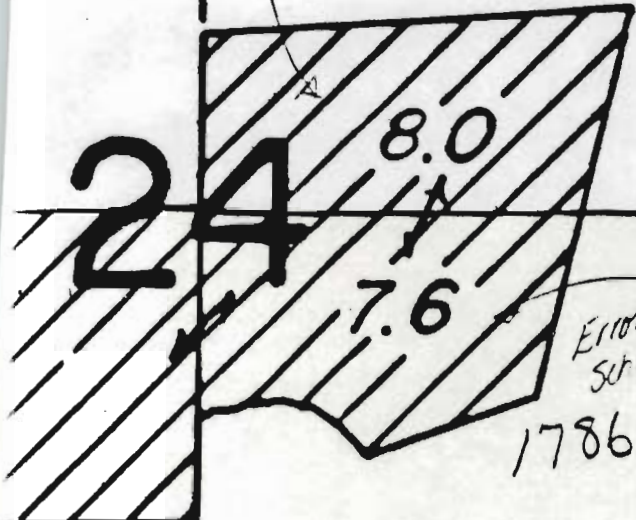

13.3  
10.7  
10.4  
13.3 = C.R.    10.7 = C.R.    4.9 = C.R.

5.2 = DES

0.3 = OUT  
(NO WATER RIGHT)

#3 Change of Water Rights

J-5475

TRANSFER TO

**RECEIVED**  
APR 25 1984  
WATER RESOURCES DEPT  
SALEM, OREGON