

**T. 9 S., R. 1 W., W.M.**

*Prelim  
change to match  
rights*

*TO PUMP  
STATION*

*Scale 1"=1320'*


*4535'*

*3460'*

*3200'*

*3900'*

*Scale 1"=1320'*

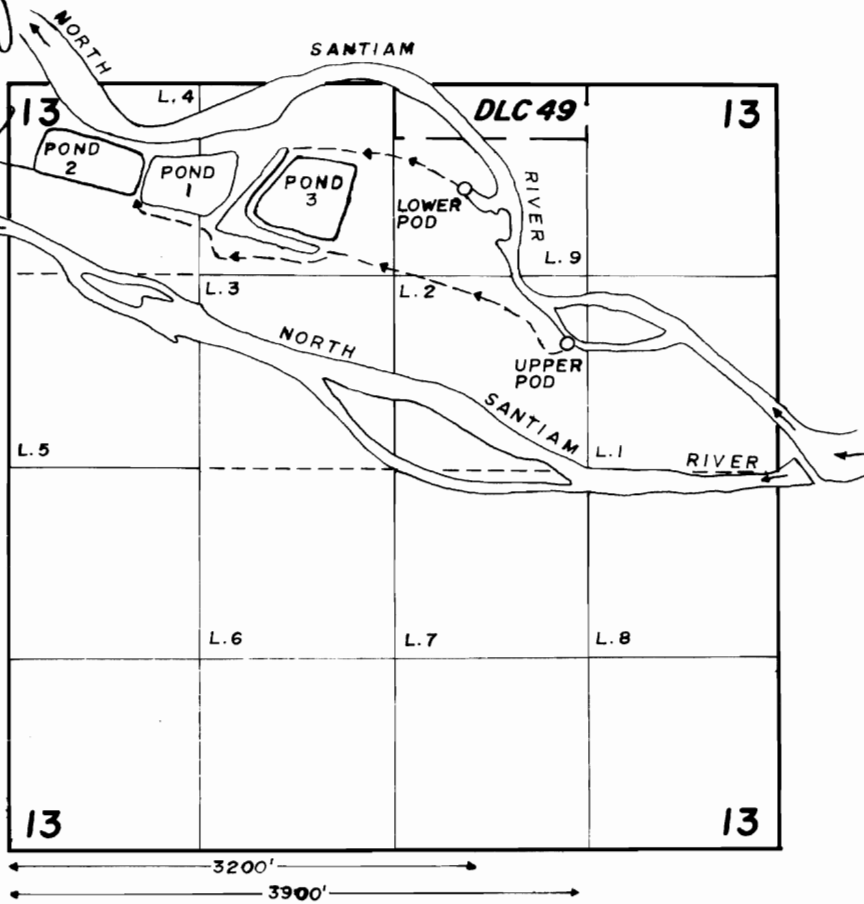

*Send to  
revision*

**FINAL PROOF SURVEY**

UNDER

**TRANSFER APPLICATION 5476**

IN NAME OF

**CITY OF SALEM**

Surveyed July 29, 1999, by Kelly Starnes