


T. 35 & 36 S., R. 1 W., W.M.

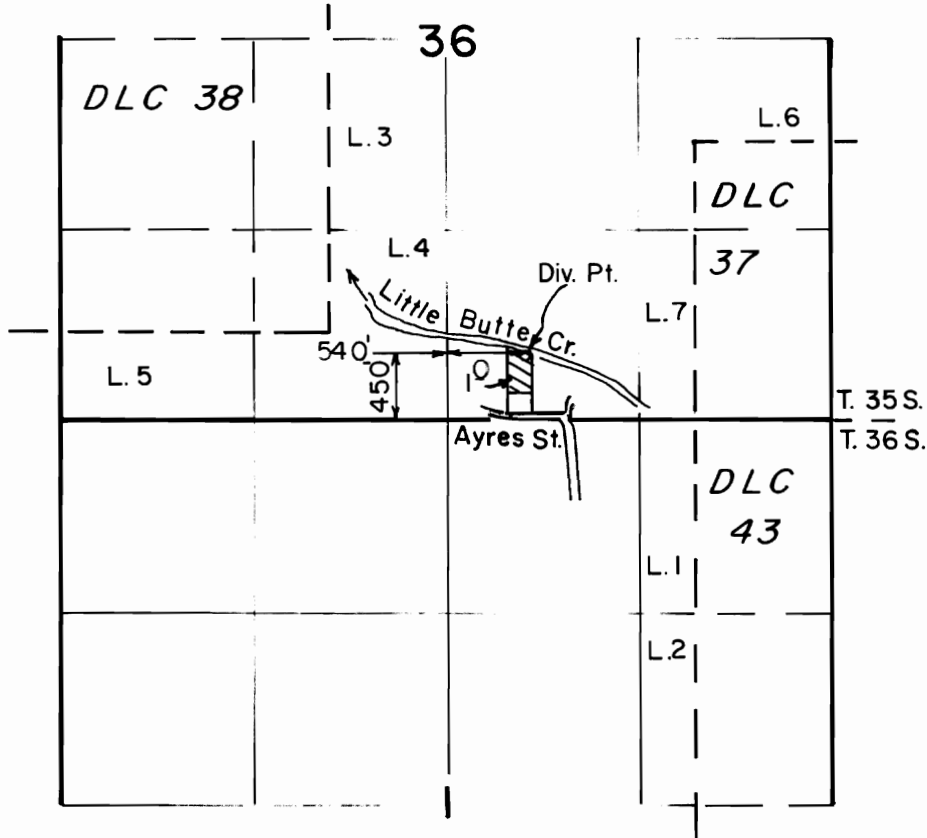

Scale: 1" = 1320'

**FINAL PROOF SURVEY
UNDER**

TRANSFER NO. 5478

Application No. Permit No.
IN NAME OF

.....ALLAN CAMPBELL.....

Surveyed JULY 17, 1991., by B. S. JAMES.....