
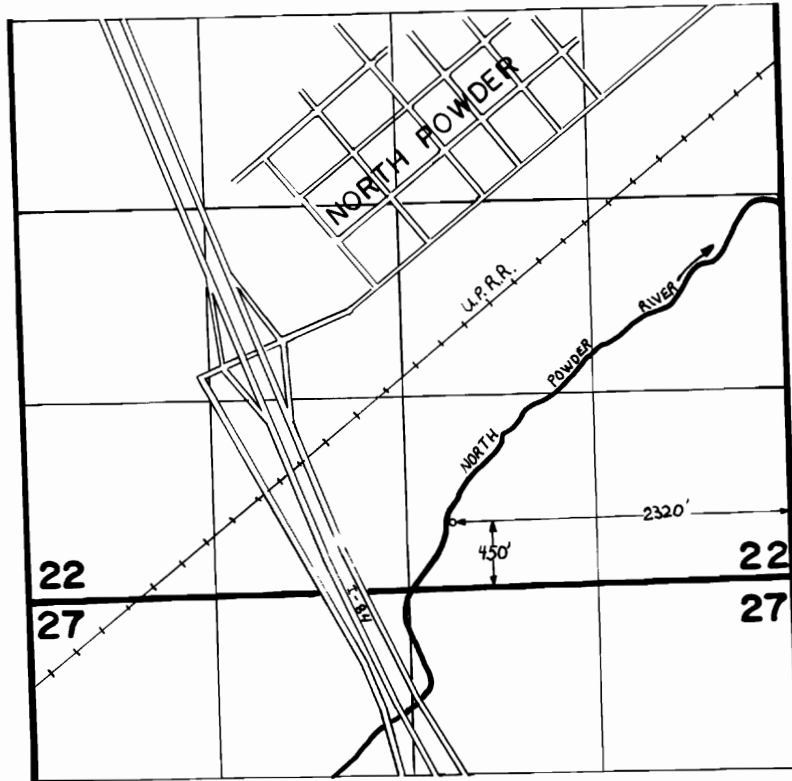


# T. 6 S. R. 39 E. W.M.

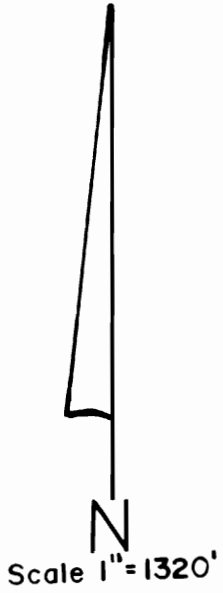

## FINAL PROOF SURVEY UNDER

**TRANSFER 5483,5484**

IN NAME OF

**ELMER D. HILL**

Surveyed August 26 1986., by V. Church.....