
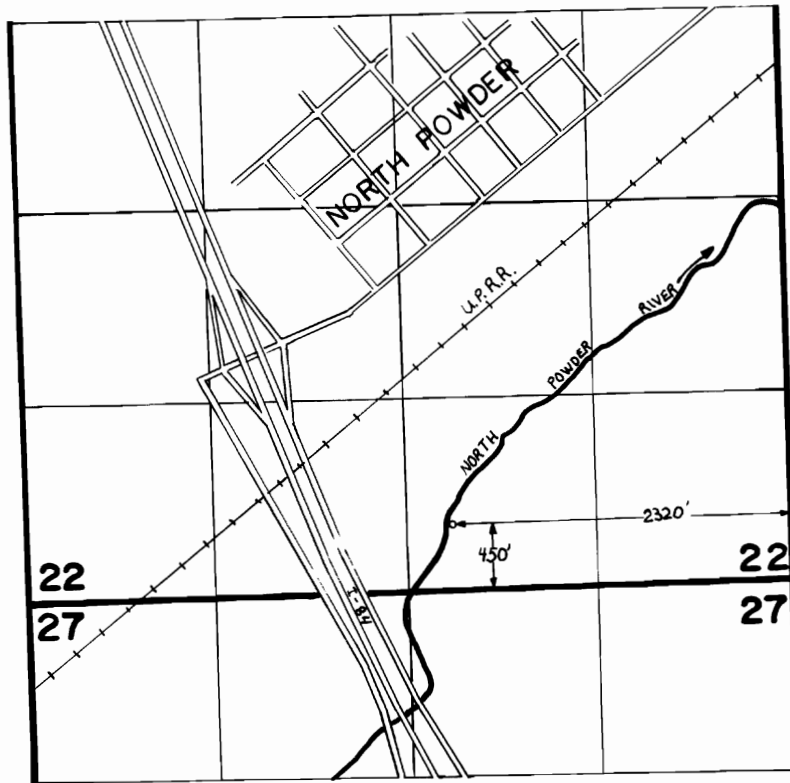


T. 6 S. R. 39 E. W.M.

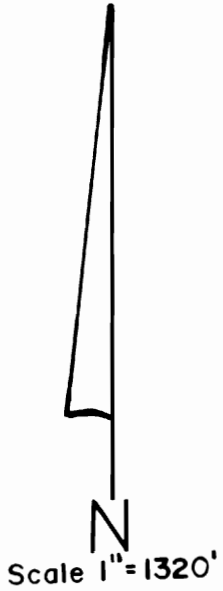

FINAL PROOF SURVEY UNDER

TRANSFER 5483,5484

IN NAME OF

ELMER D. HILL

Surveyed August 26 1986., by V. Church.....