


# T.15S., R.14E., W.M.

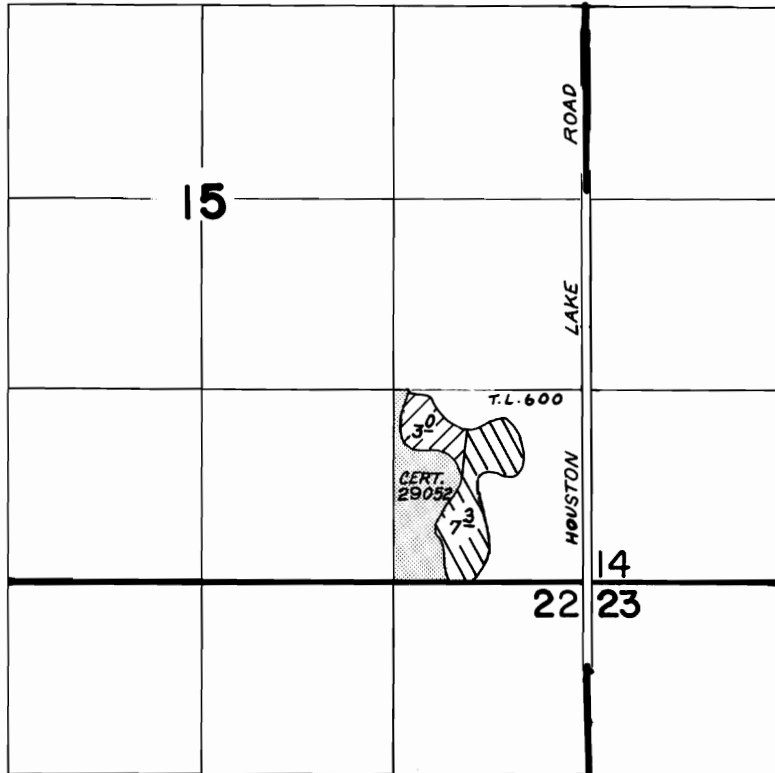

SCALE: 1"=1320'

## FINAL PROOF SURVEY UNDER

Transfer 5486 & part of Transfer 2795



IN NAME OF

.....**ERVIN CRABTREE**.....

Surveyed JULY...2.... 19.85., by .LESLIE..OLSON...

C01D  
v. 24, p. 487  
v. 38, p. 580