


# T. 39 S., R. 3 W., W. M.

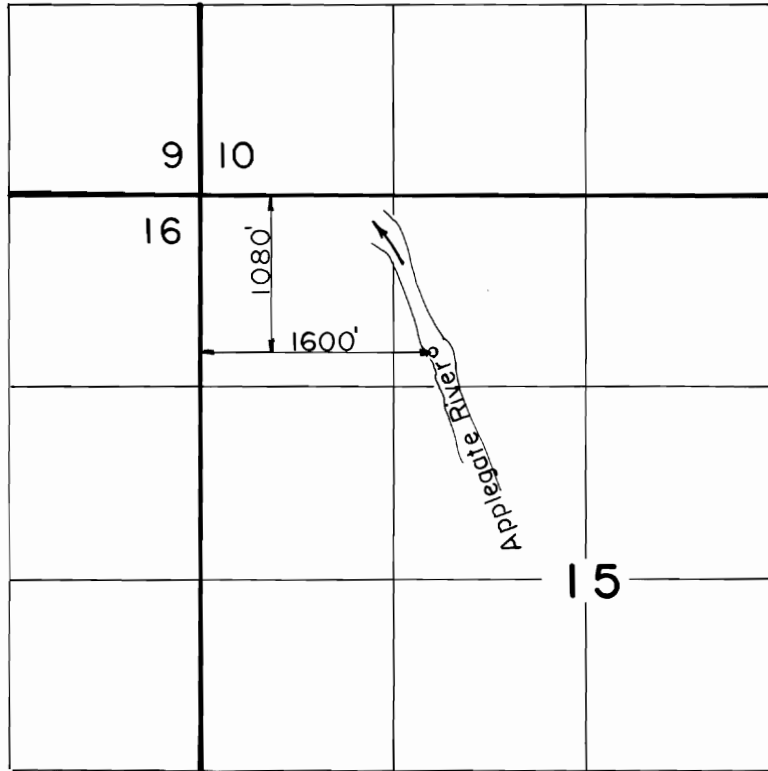

Scale: 1" = 1320'

## FINAL PROOF SURVEY UNDER

TRANSFER NO. 5496  
Application No. .... Permit No. ....  
IN NAME OF

.....JOHN L. STAYER.....

Surveyed AUG. 3. 1988., by B.S. JAMES.....