



T. 6 N. R. 35 & 36 E. W.M.

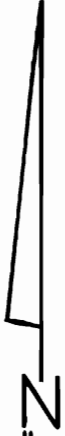

Scale 1" = 1320'

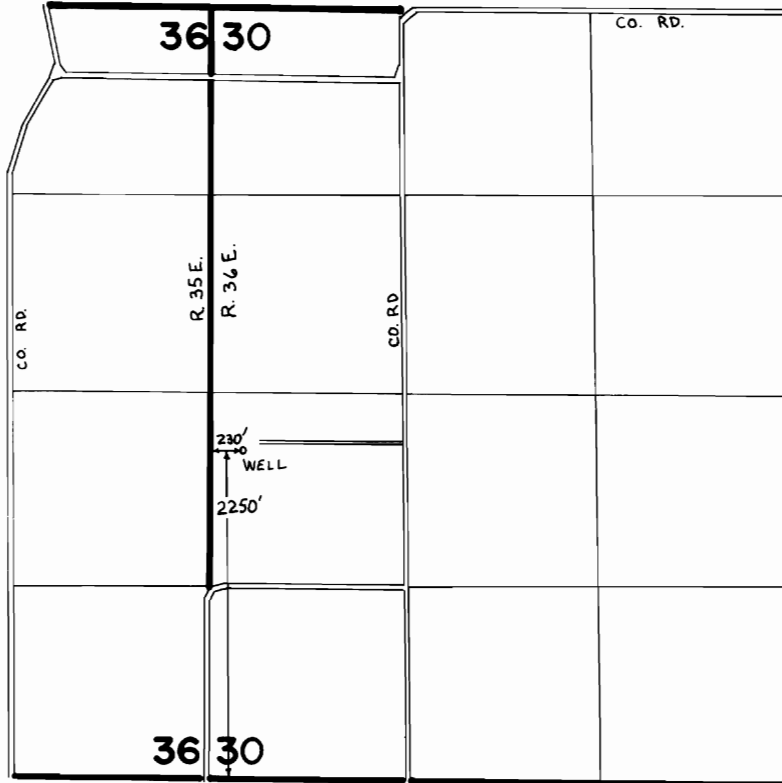

FINAL PROOF SURVEY UNDER

TRANSFER 5503

IN NAME OF

.....**WAYNE HOCKETT**.....

Surveyed March 16, 1987., by V. Church.....