


T.6S., R.1E., W.M.

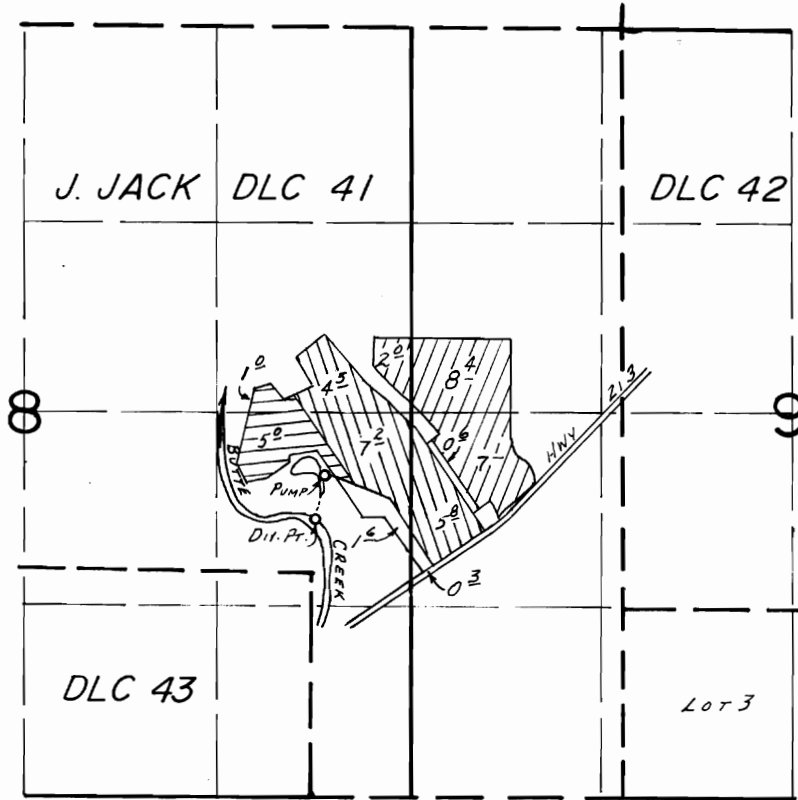


Div. Pt. Loc.: 3390'S. & 2100'W. FROM NE COR. J. JACK DLC 41

SCALE: 1" = 1320'


FINAL PROOF SURVEY

UNDER

Transfer No. 5069

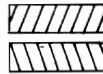

Transfer No. 5504

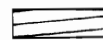

Cert. 17290(not involved)

IN NAME OF

WILBUR & DARLINE VANDERBECK

Surveyed July 23... 1984, by B.W. BISHOP.....
June 14 1985 T.M. WARREN