


RECEIVED

JUL 20 1984

WATER RESOURCES DEPT
SALEM, OREGON

SEC.

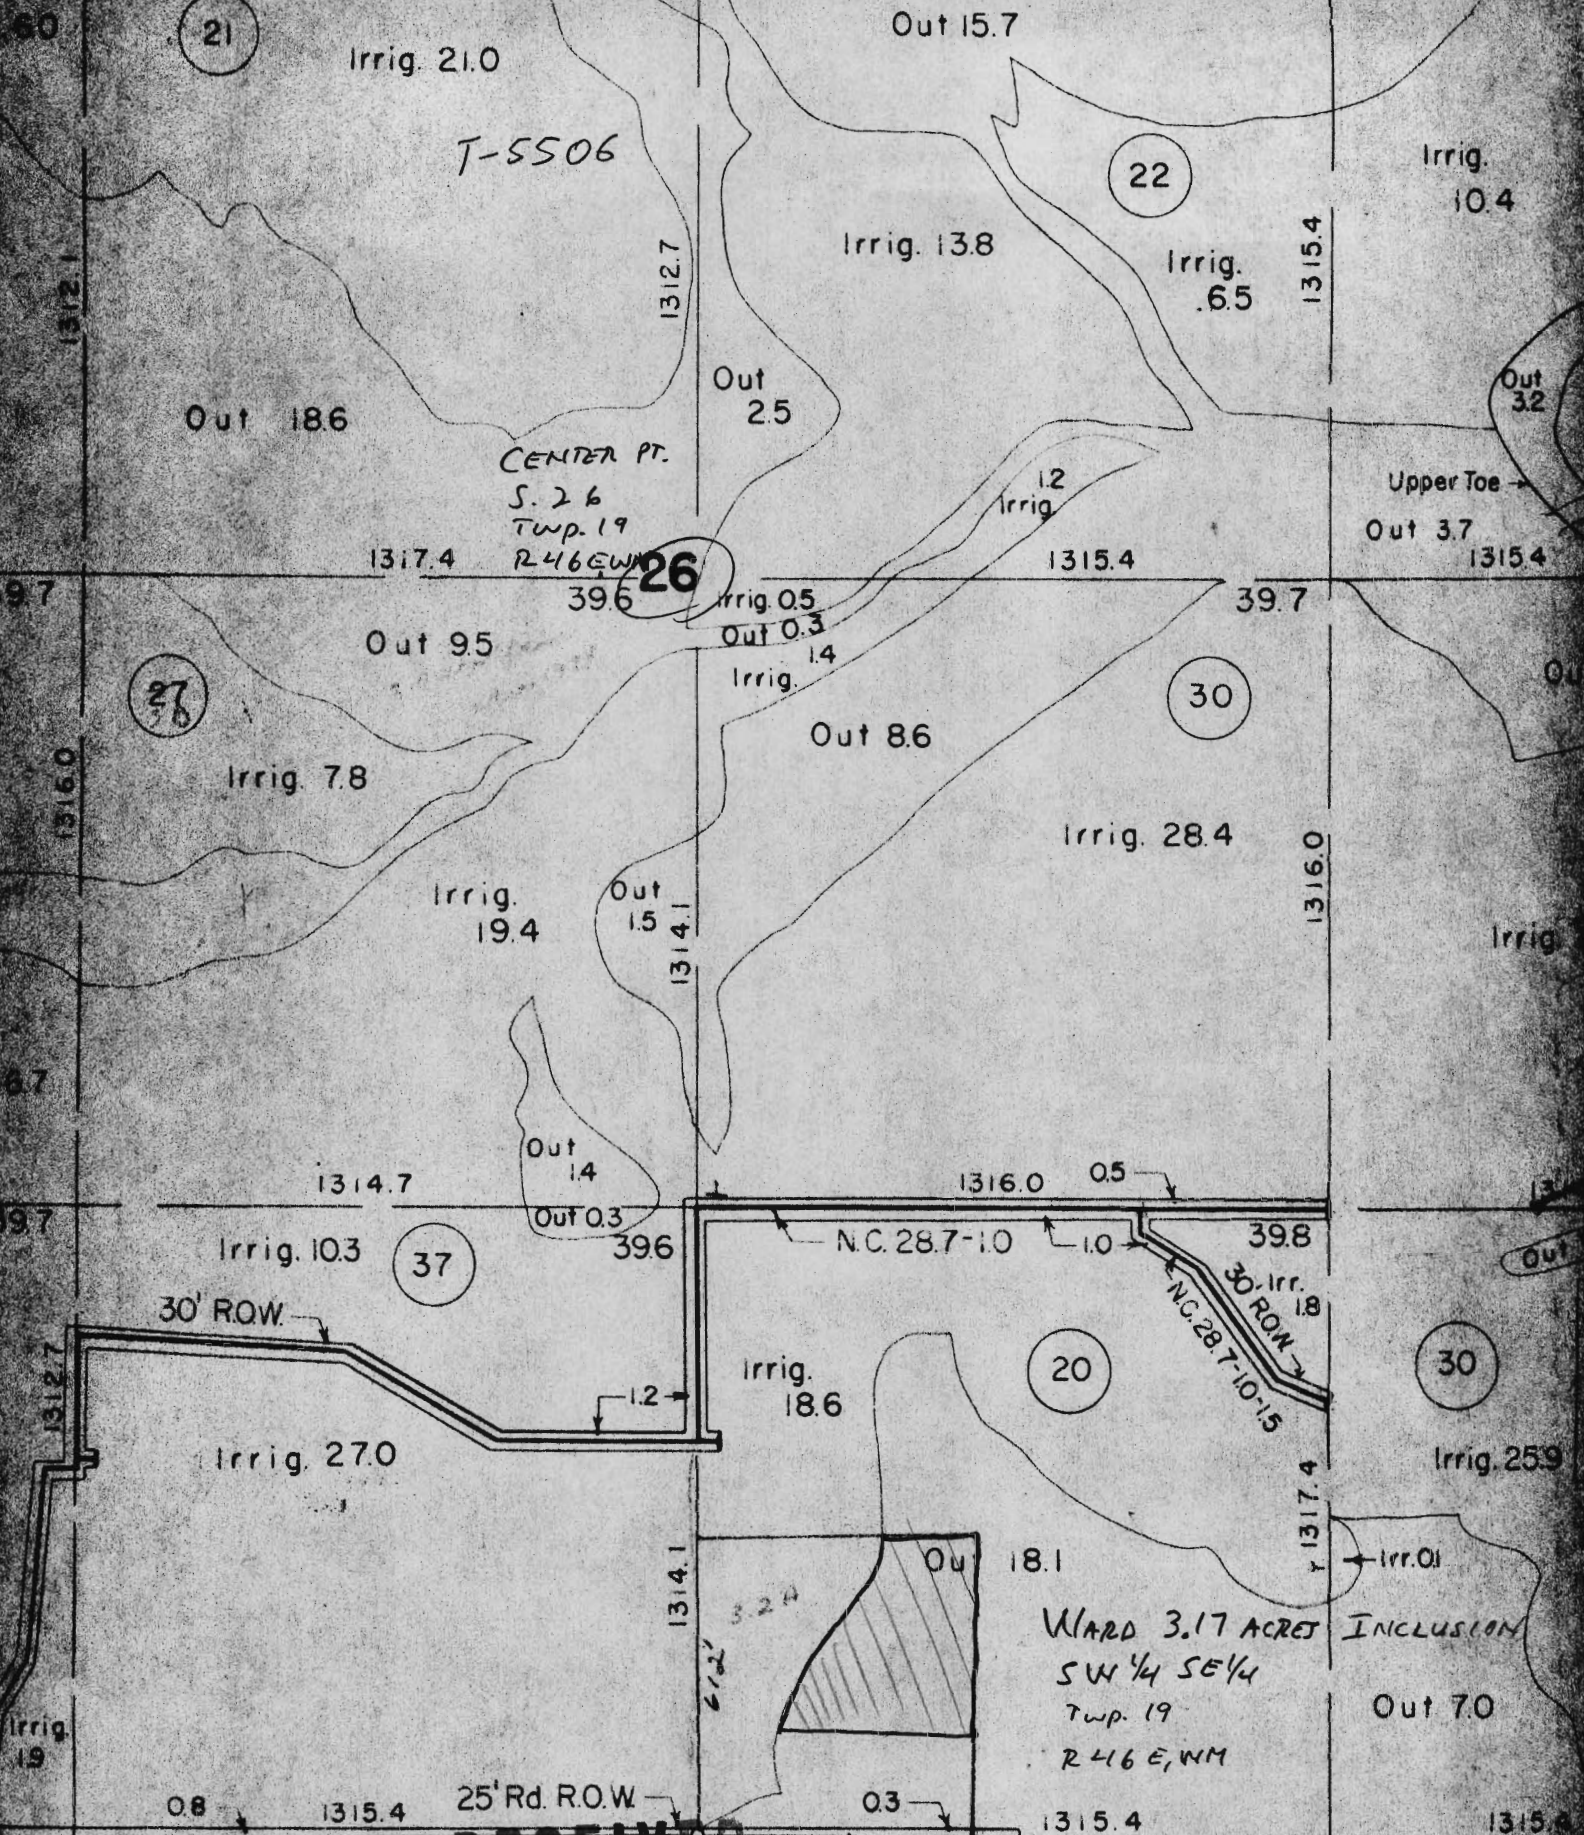

RECEIVED

JUL 20 1984

WATER RESOURCES DEPT
SALEM, OREGON

SEC. 26 - T. 19S. -

RECEIVED

JUL 20 1984

WATER RESOURCES DEPT

SALEM, OREGON

BENTZ 3 ACRES INCLUSION
NE 1/4 NW 1/4

Transferred
11-8-99
Channel Row

