
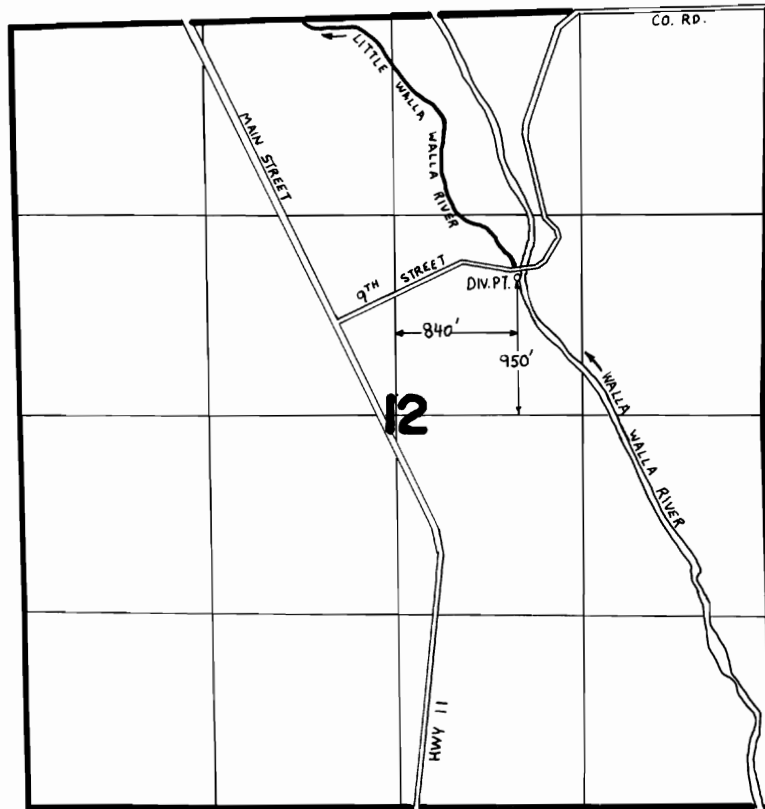


# T. 5 N. R. 35 E. W.M.

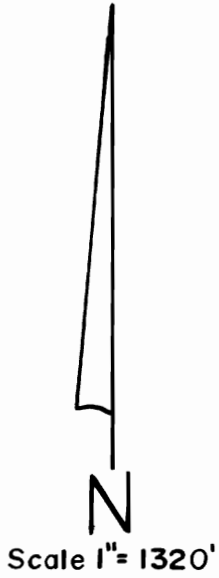

## FINAL PROOF SURVEY UNDER

**TRANSFER 5517**

IN NAME OF

**HUDSON BAY DISTRICT IMPROVEMENT CO.**

Surveyed March 2, 1987, by V. Church.....