


T. 40 S., R. 7 & 8 W., W. M.

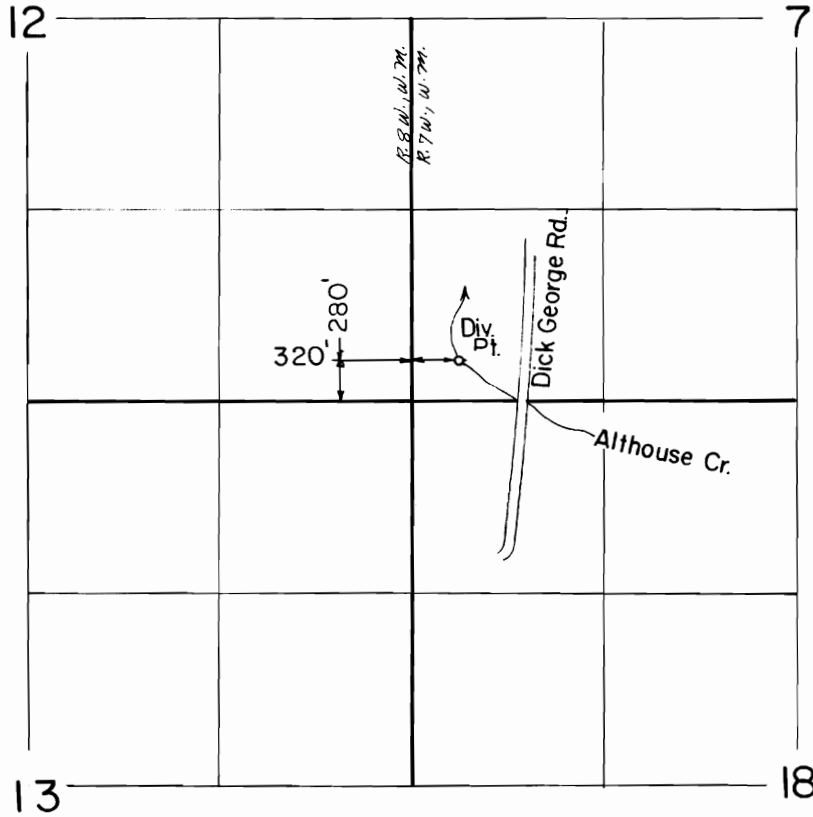

Scale: 1" = 1320'

FINAL PROOF SURVEY UNDER

TRANSFER NO. 5519

Application No. Permit No.
IN NAME OF

..... JOSEPH..... R..... JEFFRIES.....

Surveyed APR. 13..... 1988., by B..... S..... JAMES.....