


T. 1N., R. 4W., W.M.

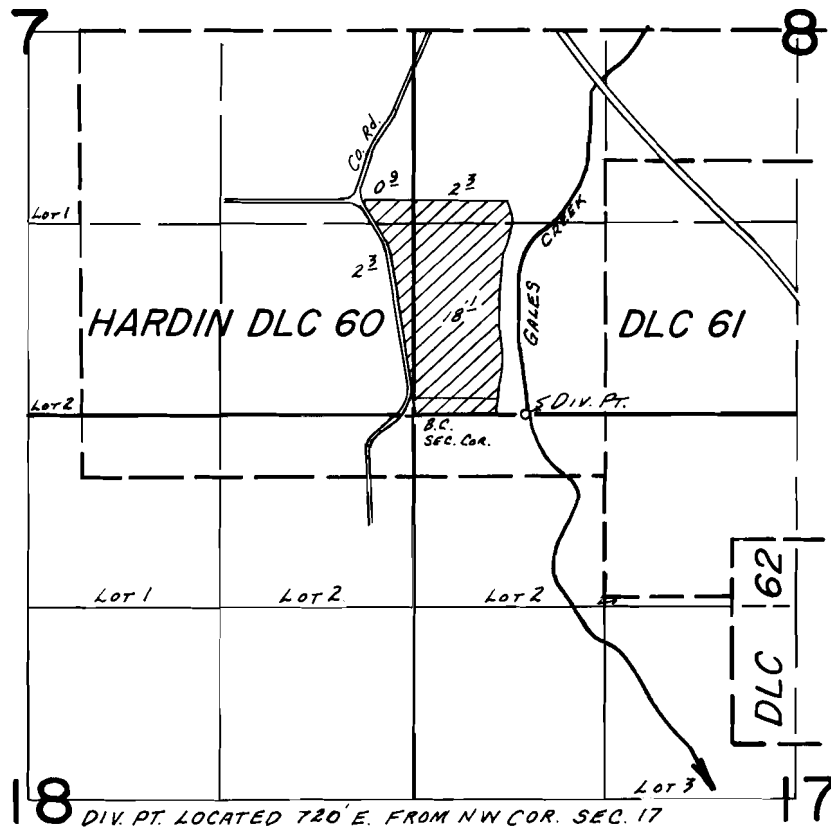

**FINAL PROOF SURVEY**  
UNDER

Application No. 55897 Permit No. 41925  
IN NAME OF

WILLIAM EVAN GILDOW

Surveyed JULY 16, 1980, by R.G. MUCKEN