




3.9 ACRES OFF


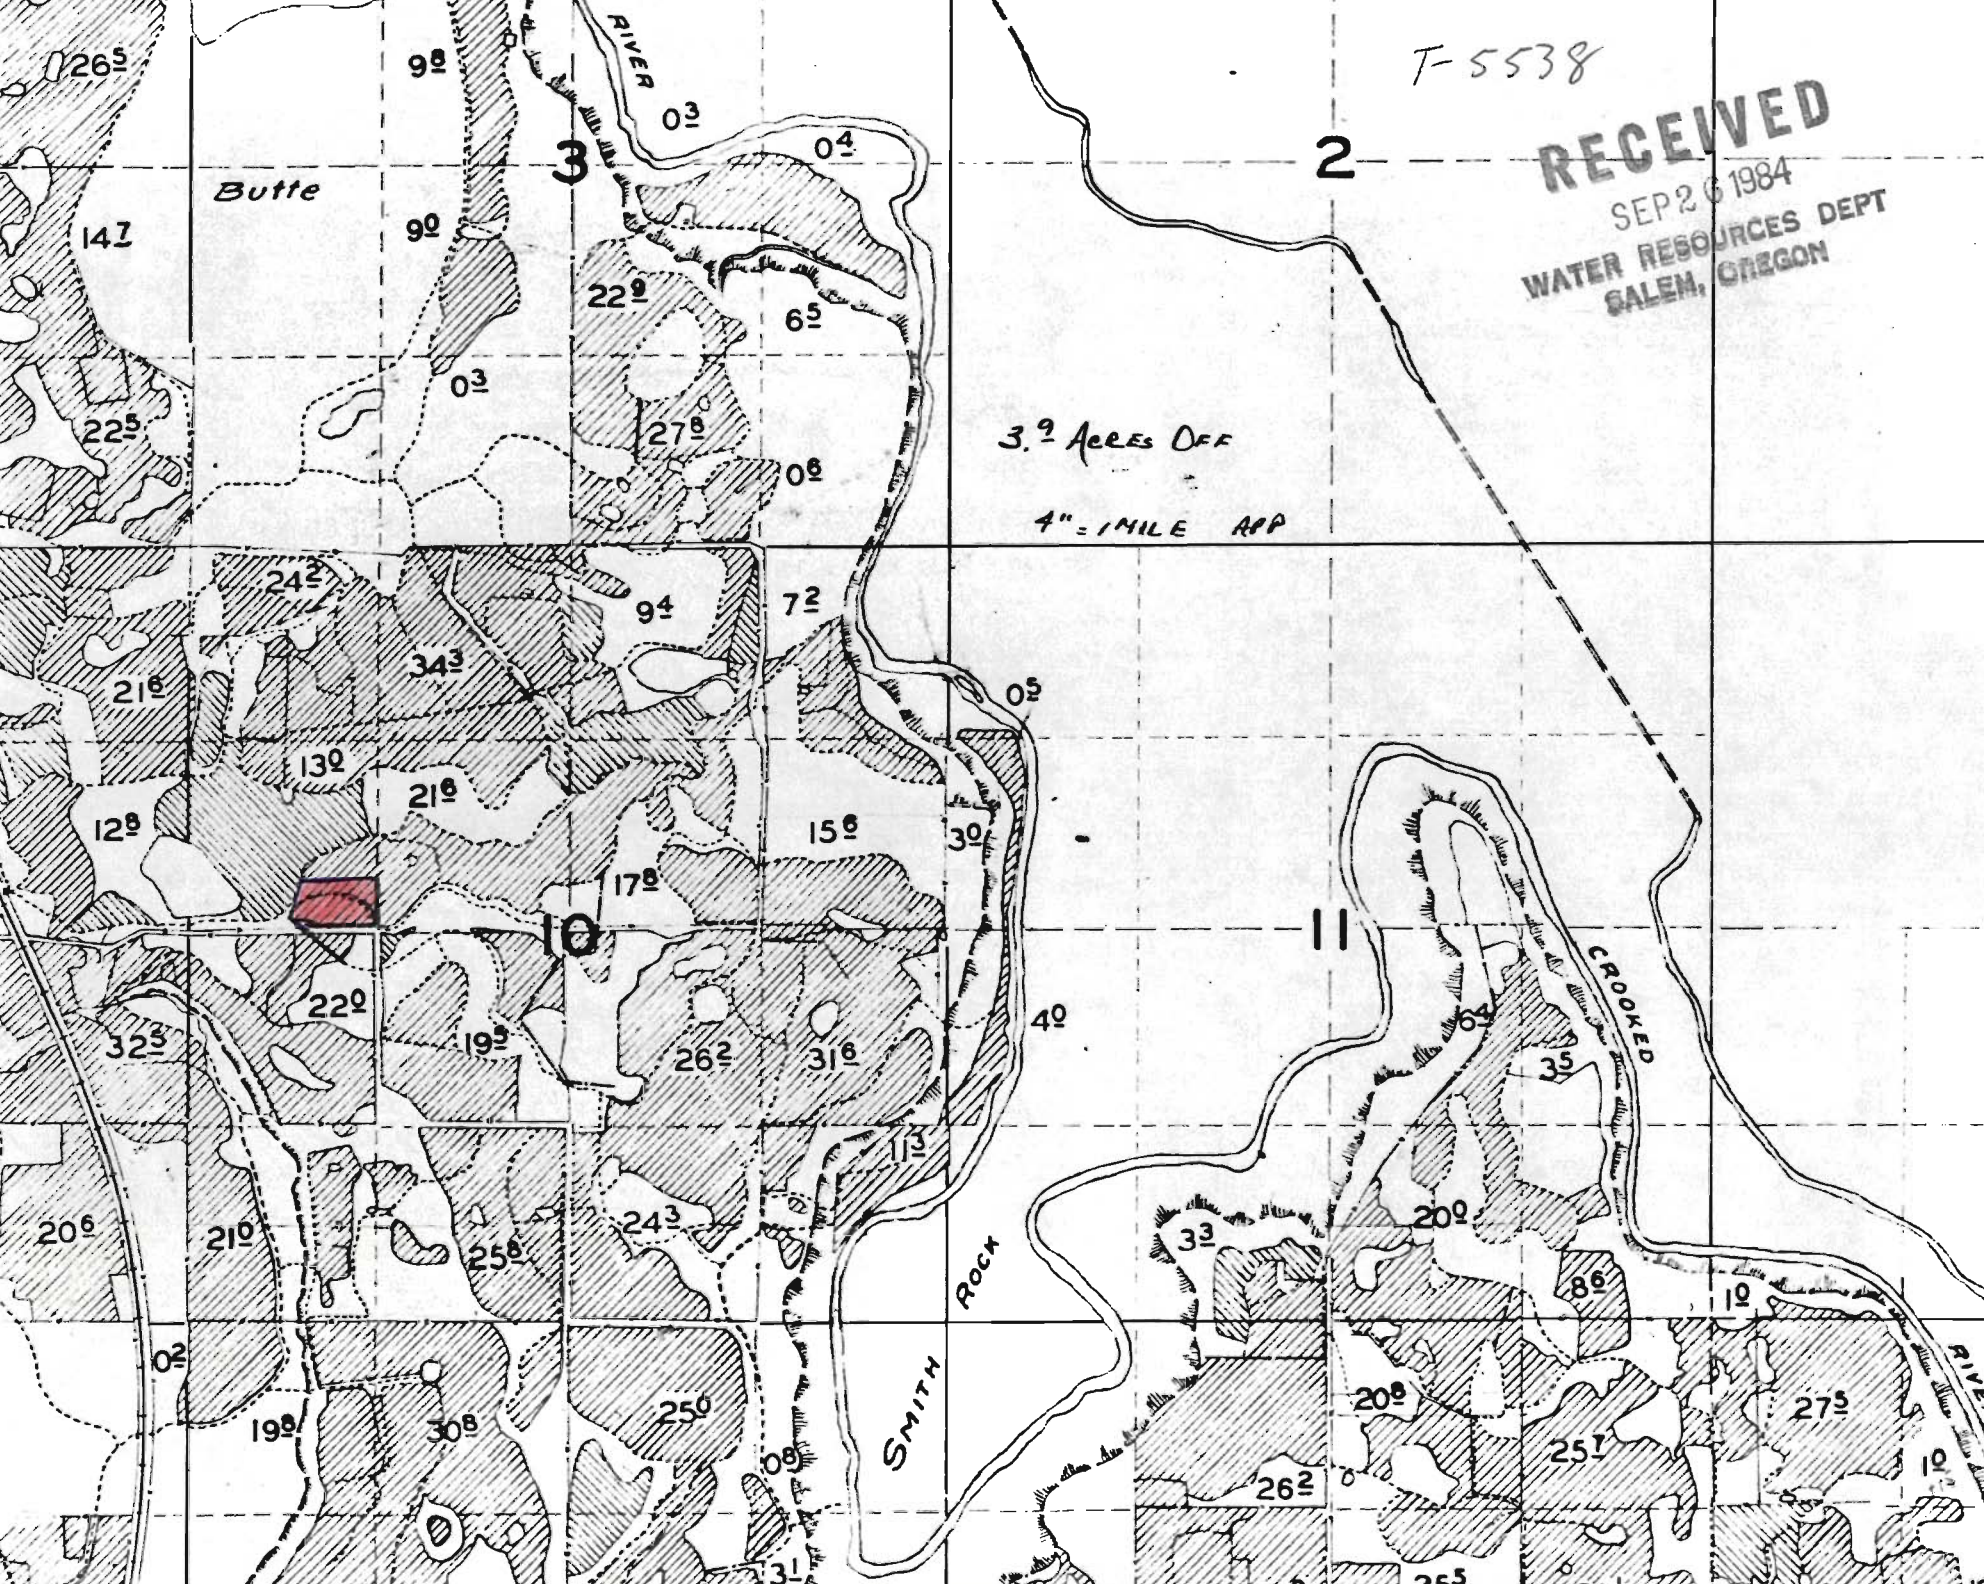

F-5538

RECEIVED
SEP 26 1984
WATER RESOURCES DEPT
SALEM, OREGON

4" = 1 MILE APP

Butte

3

2


10

11

SMITH ROCK

CROOKED

RIVER

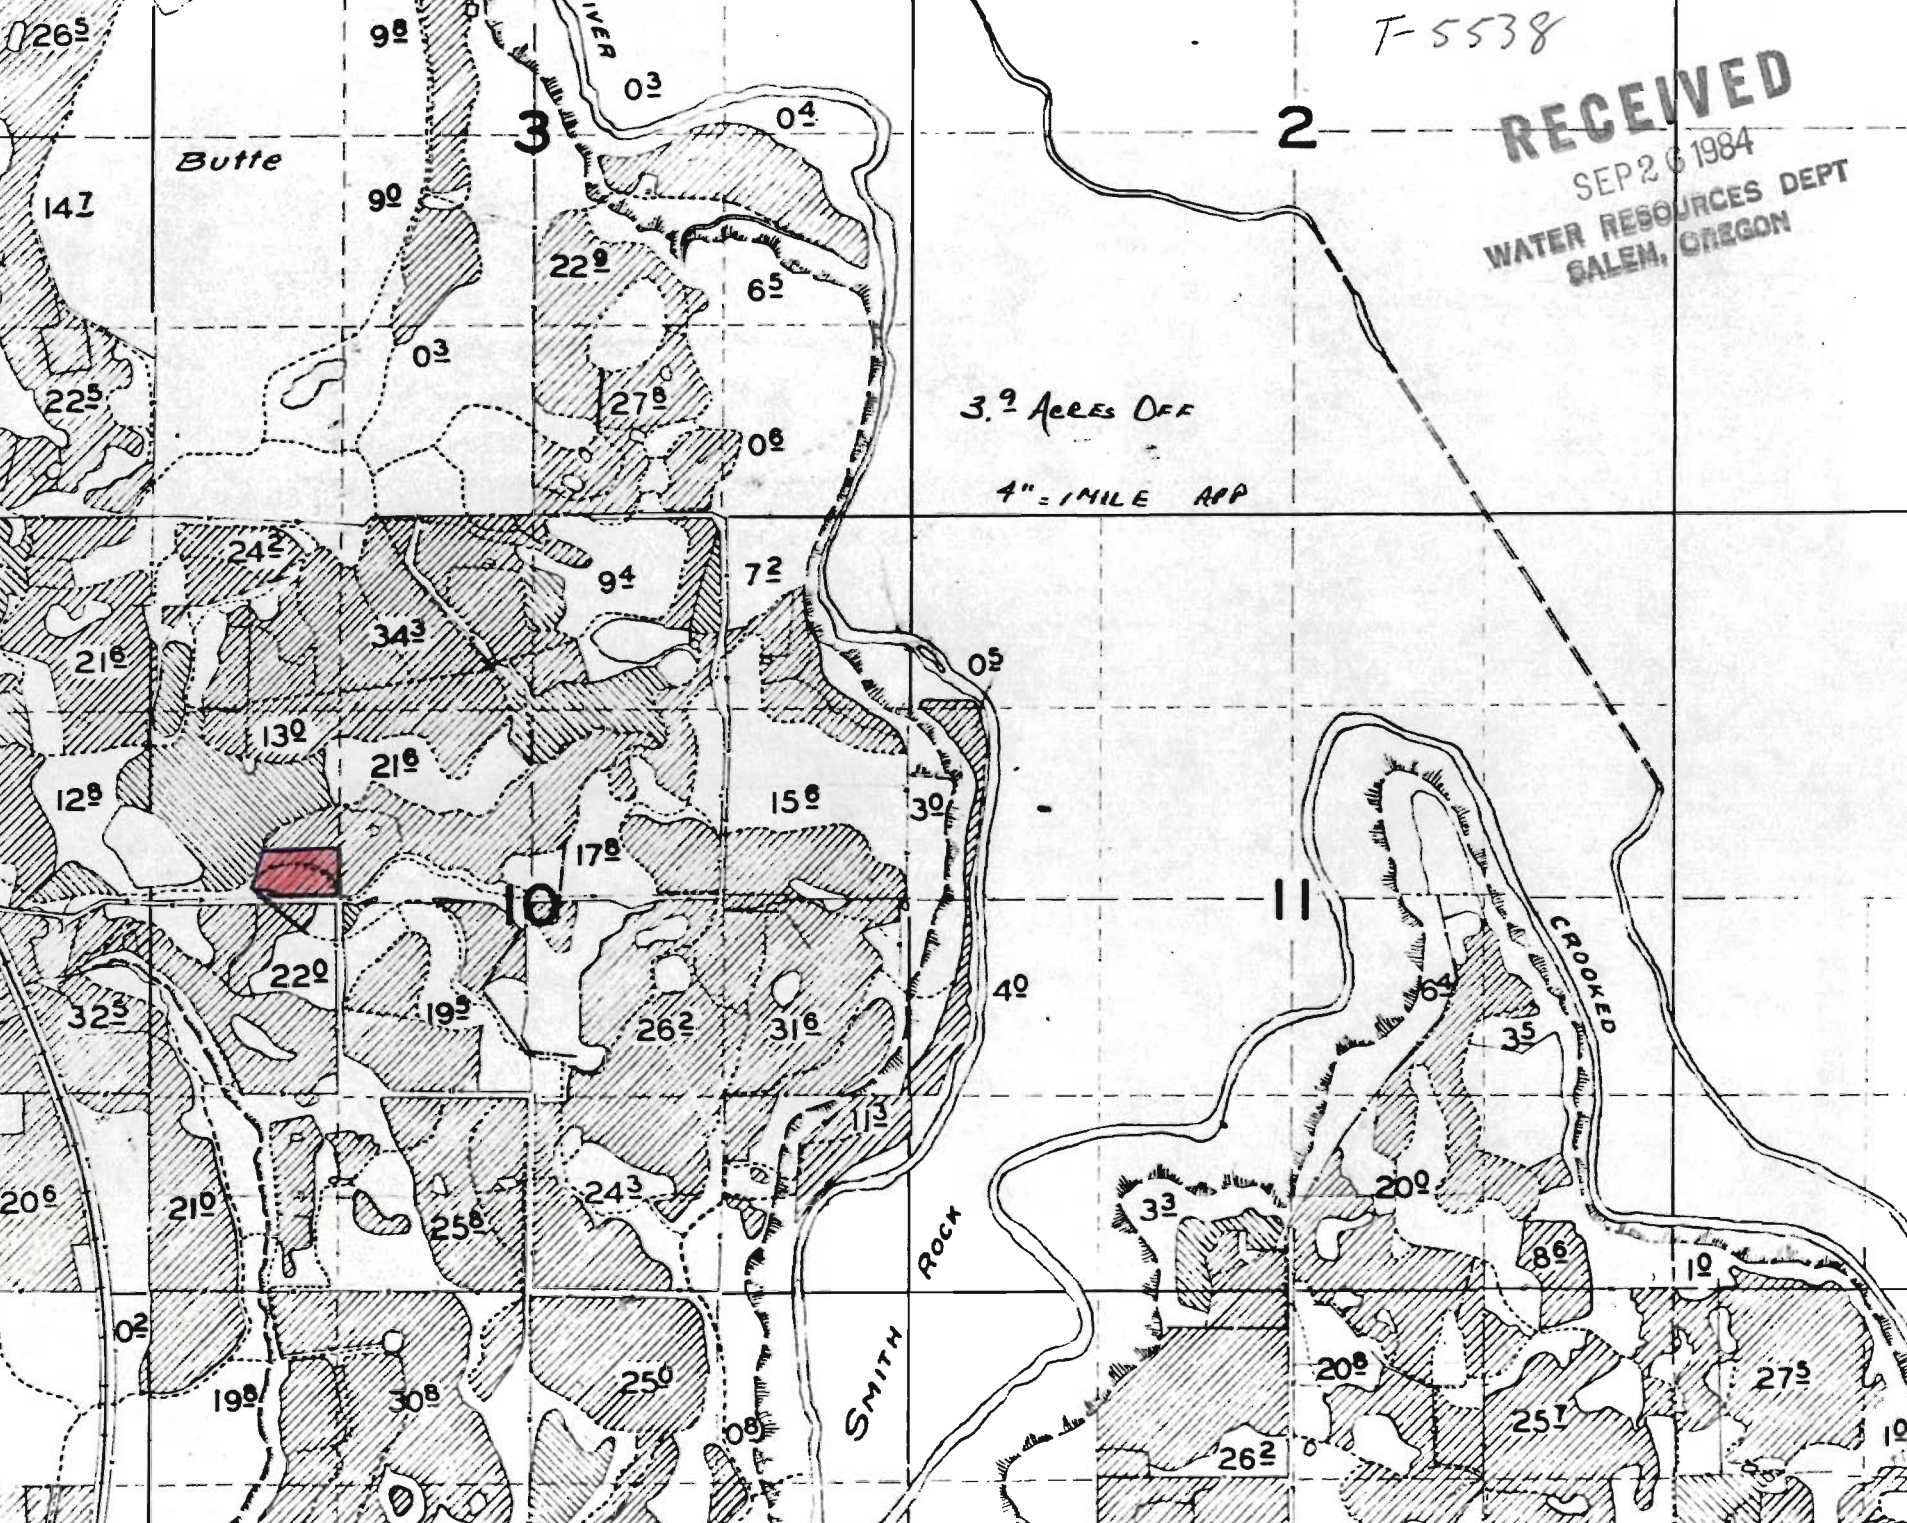

RECEIVED

SEP 26 1984

WATER RESOURCES DEPT
SALTM, OREGON

T-5538

