
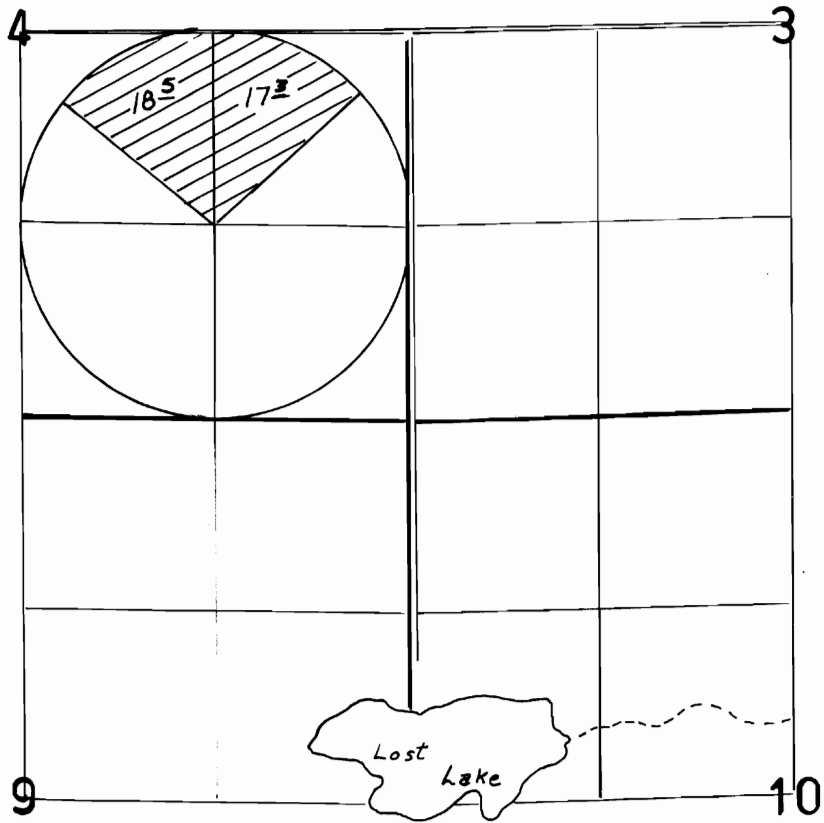


T. 3N., R. 27 E., W.M.

AUTHORISED POINTS OF APPROPRIATION

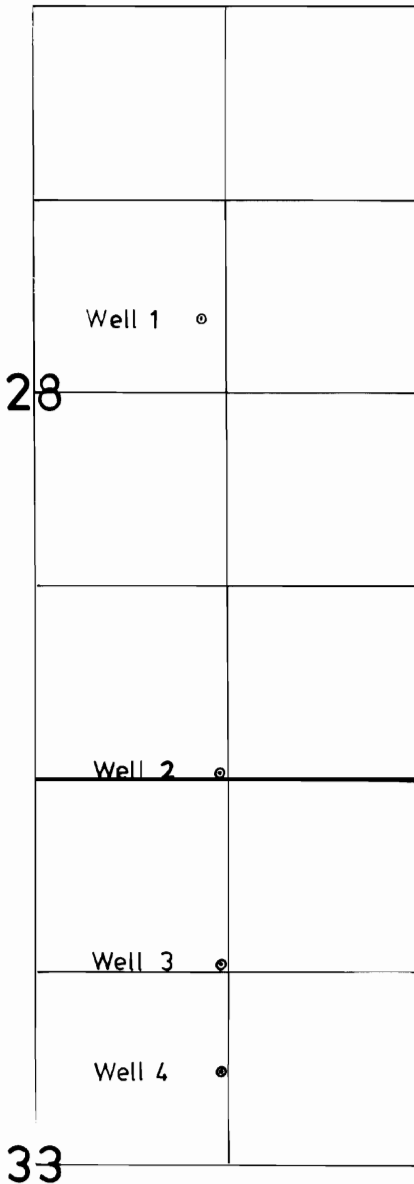

WELL POA

- # 1, SW 1/4 NE 1/4, SEC. 28, 3180'N. & 1470'W.
- # 2, SW 1/4 SE 1/4, SEC. 28, 20'N. & 1350'W., BOTH WELLS 1 & 2 BEING FROM THE SE COR. SEC. 28.
- # 3, NW 1/4 NE 1/4, SEC. 33, 1270'S. & 1350'W.
- # 4, SW 1/4 NE 1/4, SEC. 33, 1990'S. & 1350'W., BOTH WELLS 3 & 4 BEING FROM THE NE COR. SEC. 33., ALL BEING WITHIN T 4 N, R 27 E, W.M.



FINAL PROOF SURVEY

UNDER

Transfer No. 5543
IN NAME OF

TRI-SET, INCORPORATED

Surveyed 8,15, 1995, by J. MILLER

1" = 1320'