



T. 17S., R. 21E., W.M.

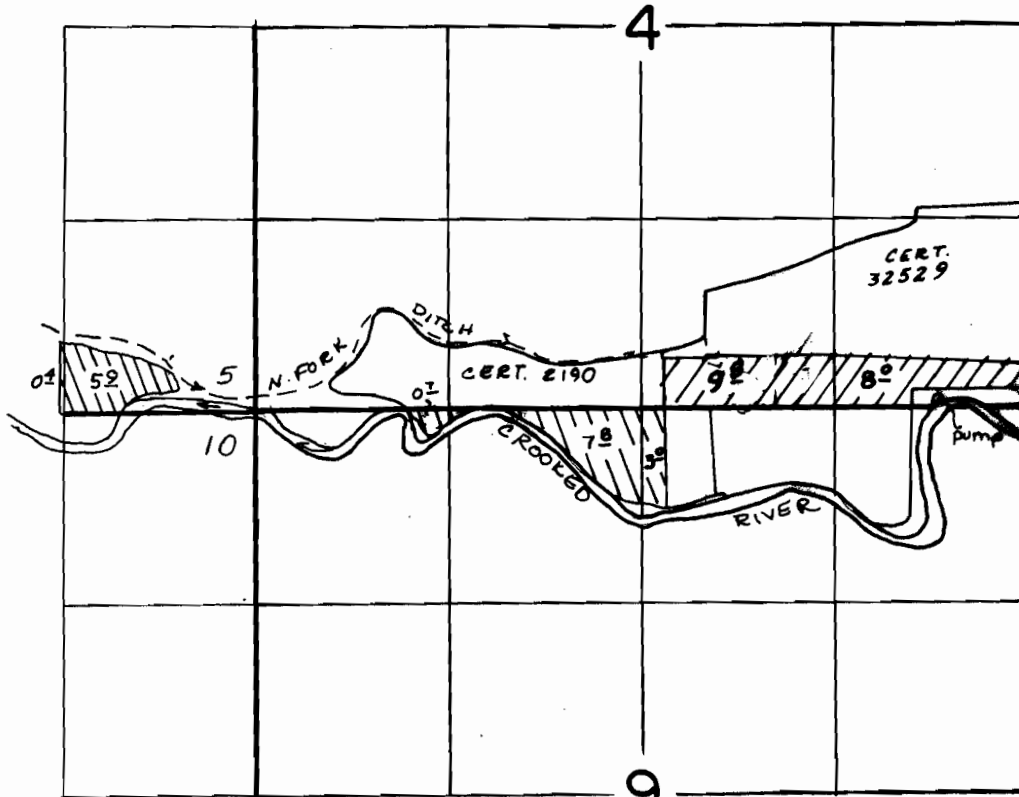

Pump: 60' N & 600' W from the SE Cor. Sec. 4

- NORTH FORK SOURCE
- CROOKED RIVER SOURCE

SCALE: 1" = 1320'

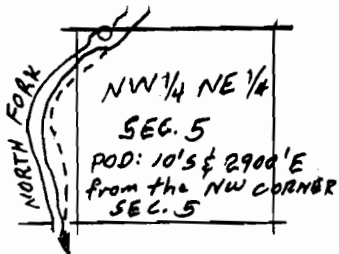

FINAL PROOF SURVEY

UNDER

Transfer 5544

IN NAME OF

LES SCHWAB WAREHOUSE CENTER

Surveyed Oct. 28, 1985, by L. OLSON