


T. 4S., R. 12 & 13E., W. M.

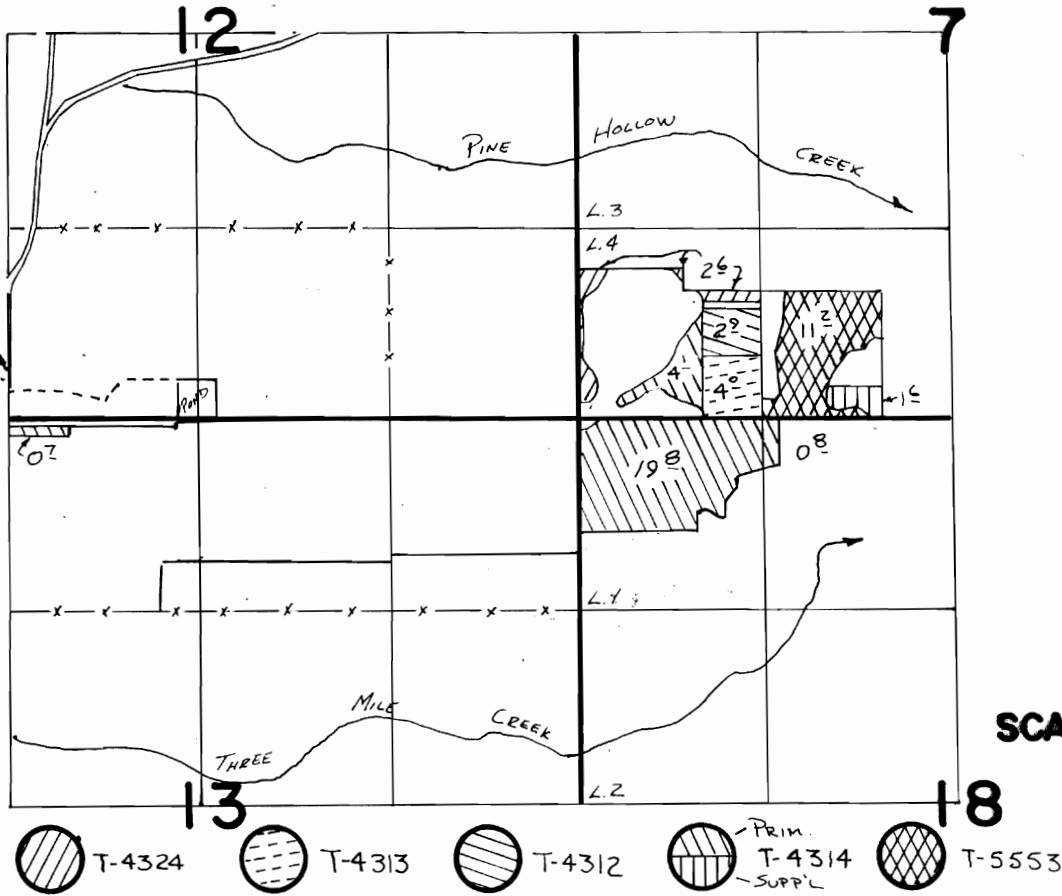


FINAL PROOF SURVEY
UNDER

TRANSFERS 4324, 4313, 4312, 4314, 5553
IN NAME OF

.....**RAY A. BENZEL**.....

Surveyed 10-18 1988, by V.L. Church.....

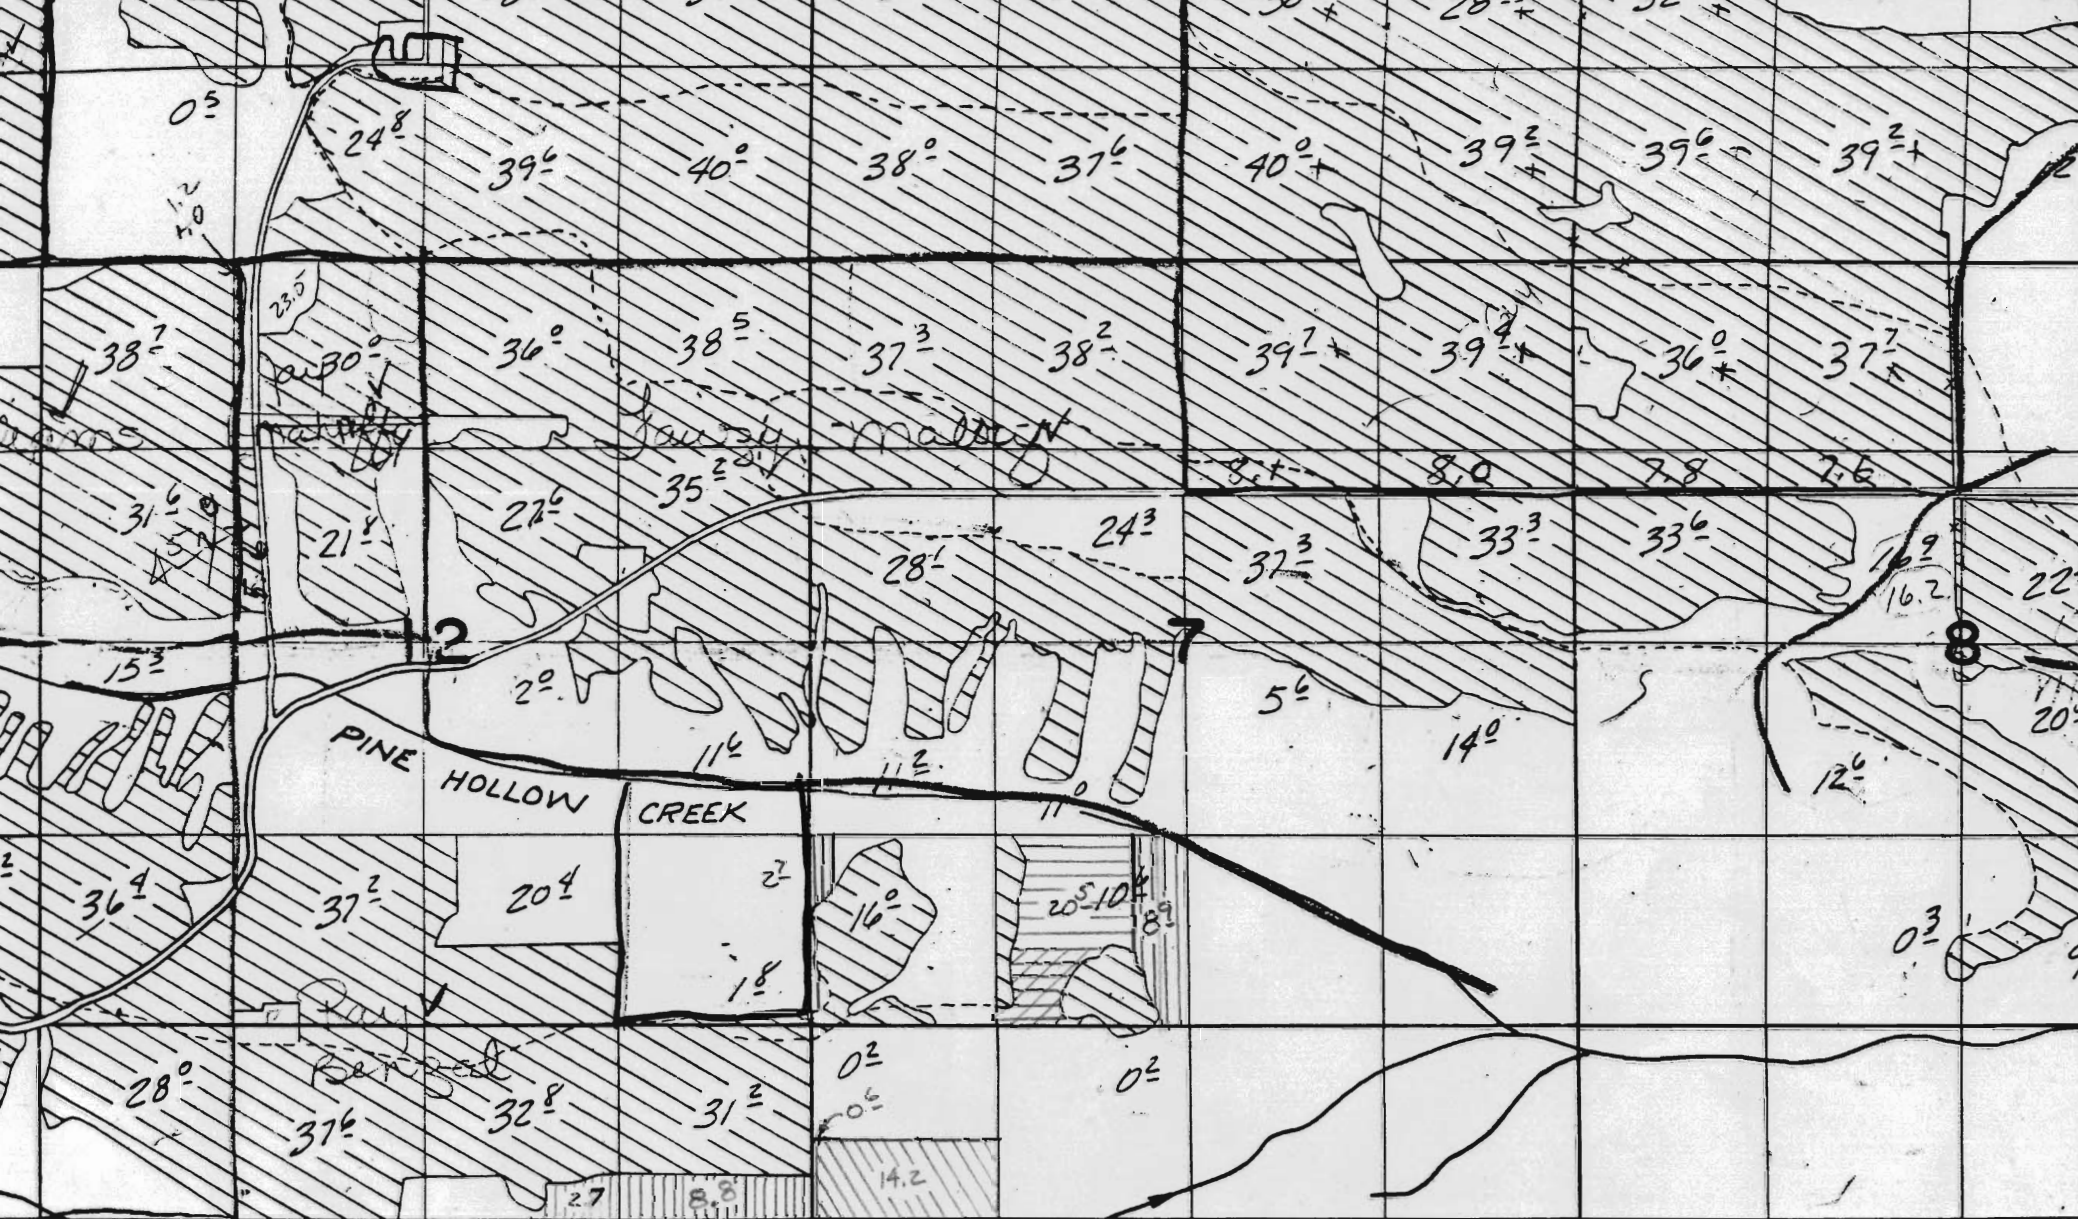

RECEIVED

OCT 12 1984

WATER RESOURCES DIVISION
SALEM, OREGON

THREEMILE CREEK

18

T-5551, 5552,
5553

CERT 5764
PRIMARY CERT 46368
CERT 46529
SUPPLEMENTAL CERT 46368

17