

T-5558

RECEIVED

NOV 19 1984


WATER RESOURCES DEPT
SALEM, OREGON

TO:

Sec. 18 T.4N. R.29E.W.M.

UMATILLA COUNTY

1" = 1000'

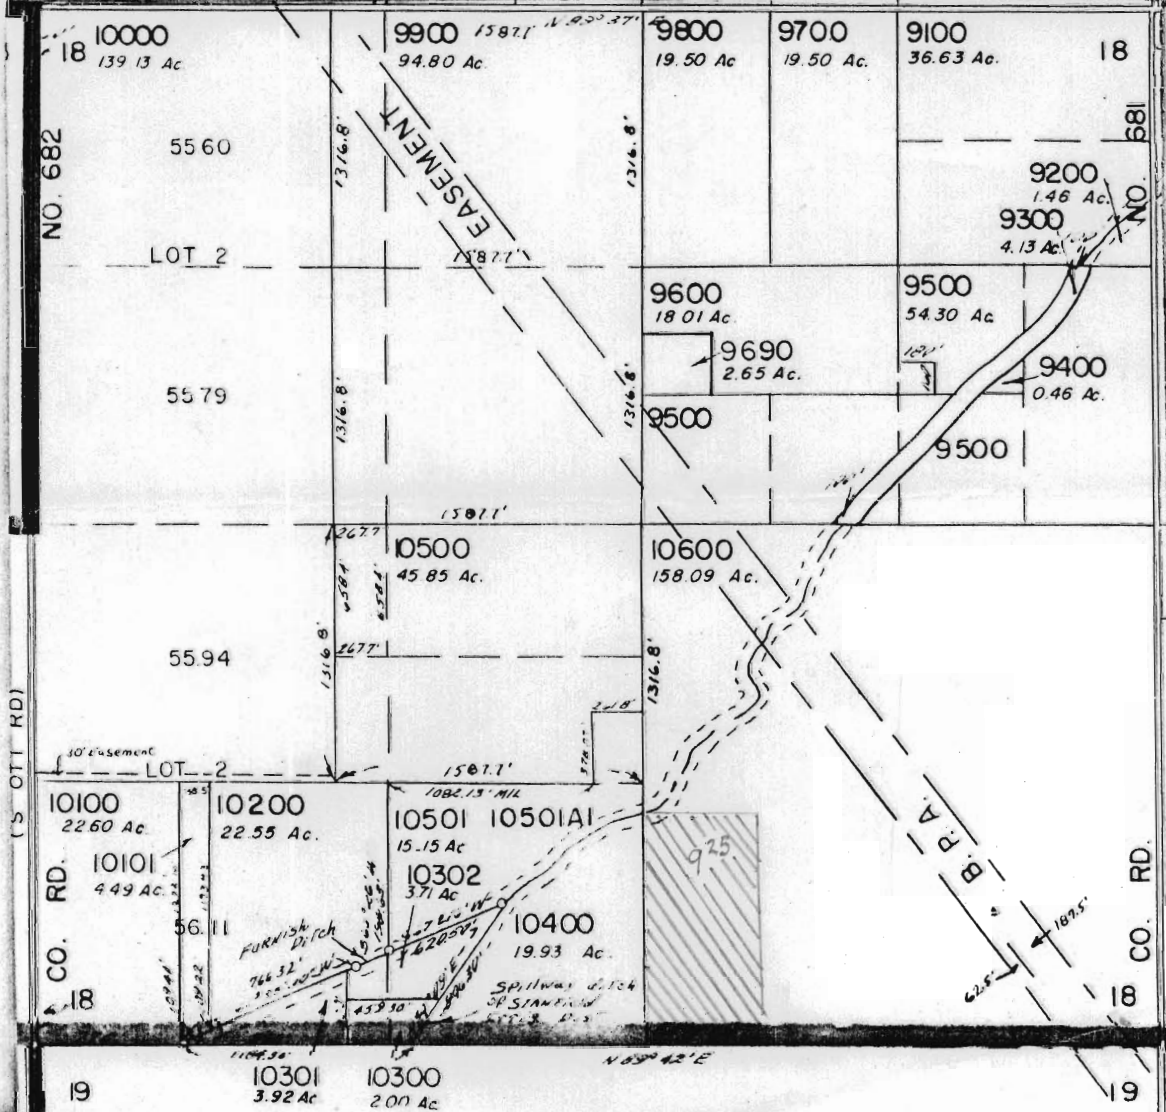

009214

T-5558

FROM

TWP. 4 N., RG. 29 E. NW1/4 SEC. 27

Scale: 1 in. = 400 ft.

