


RECEIVED

DEC 4 1984

WATER RESOURCES DEPT
SALM, OREGON

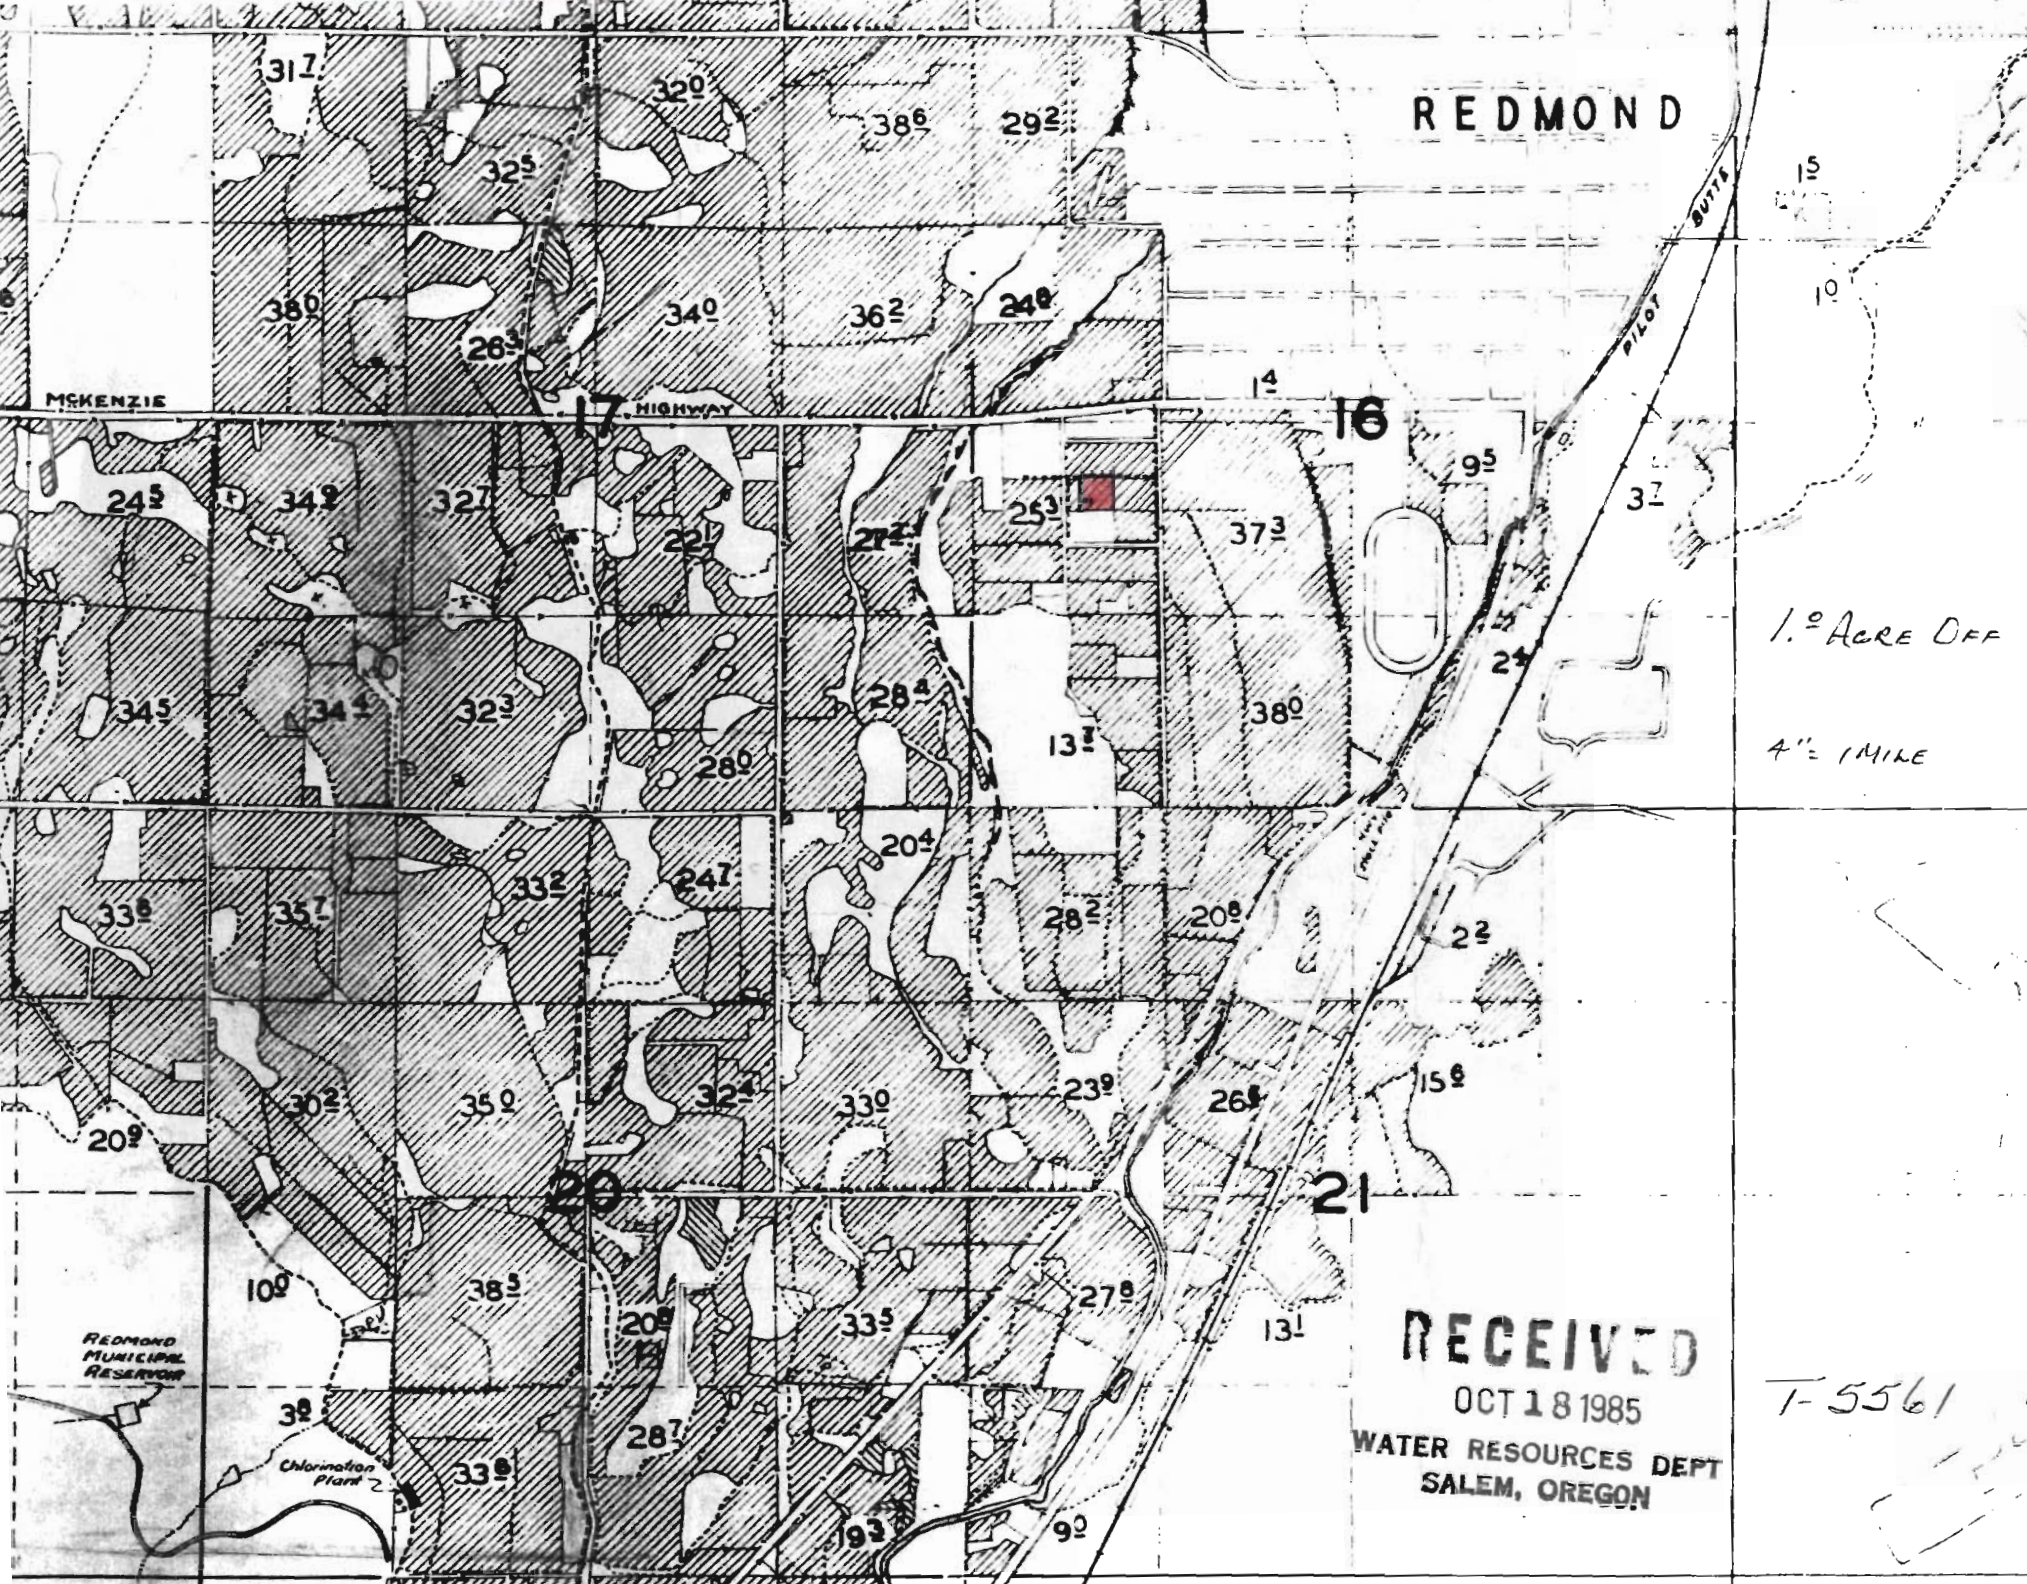

REDMOND

MCKENZIE

HIGHWAY

16

1.0 ACRE OFF

4" = 1 MILE

RECEIVED

OCT 18 1985

WATER RESOURCES DEPT
SALEM, OREGON

T-5561

REDMOND MUNICIPAL RESERVOIR

Chlorination Plant 2