

36.0

38.8

JOHNSON

ARMSTRONG

RODMAN

RECEIVED

DEC 14 1984

WATER RESOURCES DEPT
SALENT OREGON

17

ROL

938

937

32.7

~~17.0~~
14.3

16.5

PAUL HEBB

PAUL HEBB

0.7

4.2

CITY PARK

934-1

H&H
DEVEL.

PAUL HEBB

2.7

17.3

RAH

BB.

RODMAN

1.8

1.4

B

SECTION: 17

<2.7> NESW
<17.3> SESW

TRANSFER OUT

20.0 DESCHUTES
WATER RIGHTS

TOWNSHIP: 12

FROM: PAUL HEBB

RANGE: 13

F-5565

To: GARY D. AND K. DARLENE DINKEL

SECTION: 8


TOWNSHIP: 12

RANGE: 13

SENE

20.0

TRANSFER IN: 20.° DESCHUTES WATER RIGHTS

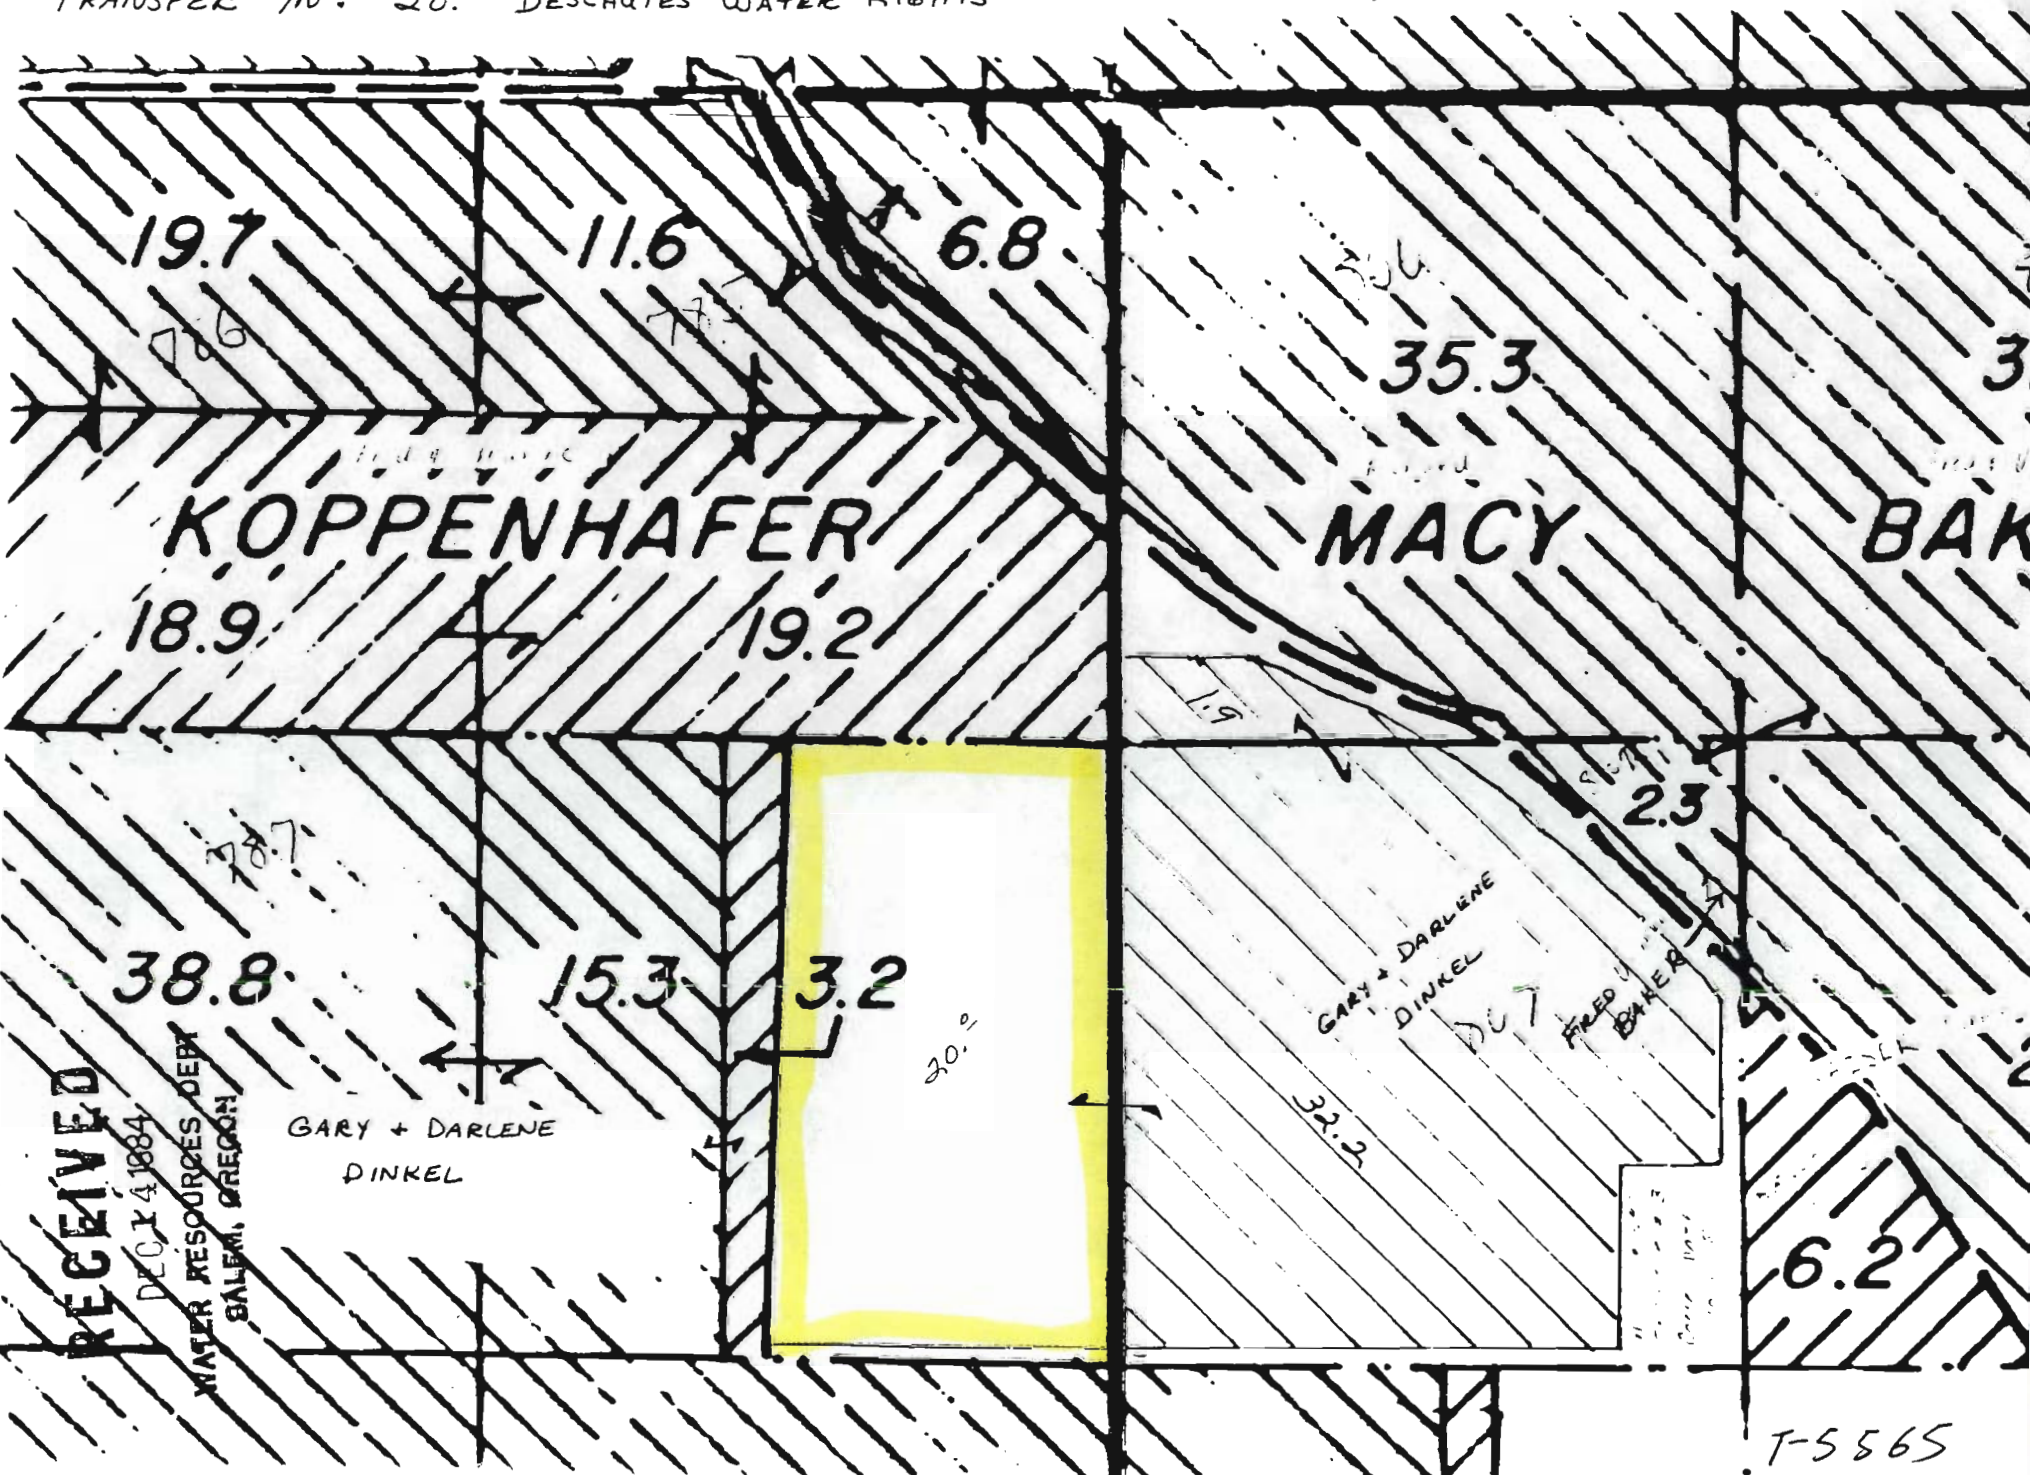

RECEIVED

DEC 14 1984

WATER RESOURCES DEPT
SALEM, OREGON

GARY + DARLENE
DINKEL

T-5565