


T. 30S., R. 5 W., W.M. SECTION 34

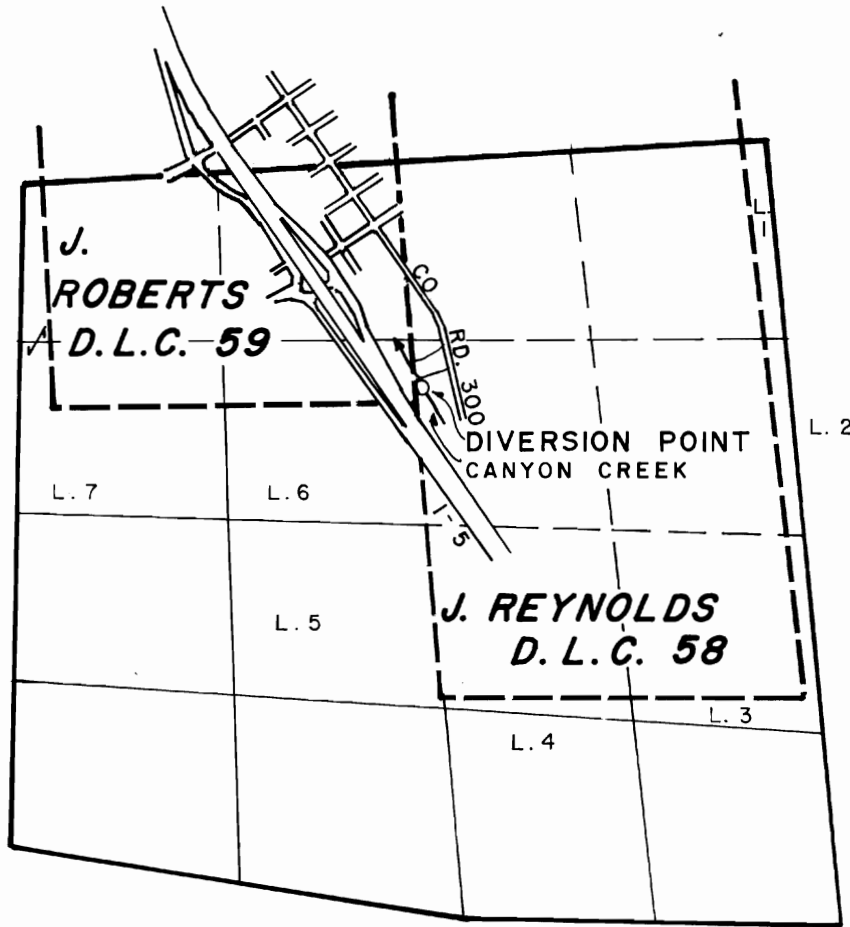

DIVERSION POINT LOCATED 100' N. & 50' E. FROM SE CORNER D. L. C. 59.

SCALE: 4" = 1 MILE

FINAL PROOF SURVEY UNDER

Transfer Number 5572
IN NAME OF

ERNEST S. PECK

Surveyed APRIL 22 1987, by J. M. SCHMORDE