


T.17S.R.12E.W.M.

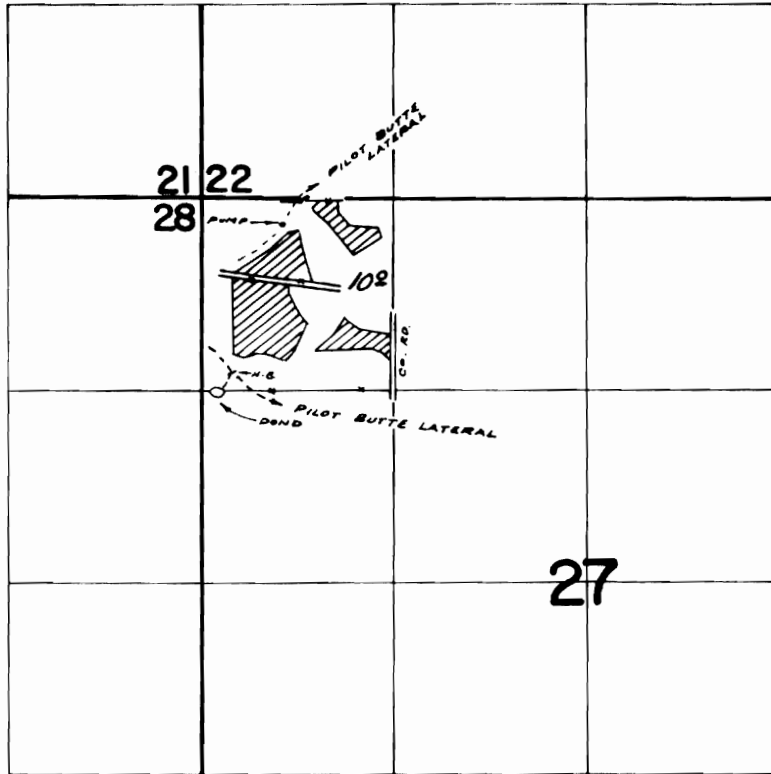

FINAL PROOF SURVEY
UNDER

Transfer No. **K-43**
Application No. Permit No.
IN NAME OF

RICHARD D. KERR

Surveyed **MAR. 26. 27.** 19.70., by D. **BUELL**.....