



T-5574

RECEIVED

DEC 27 1984

WATER RESOURCES DEPT
SALEM, OREGON

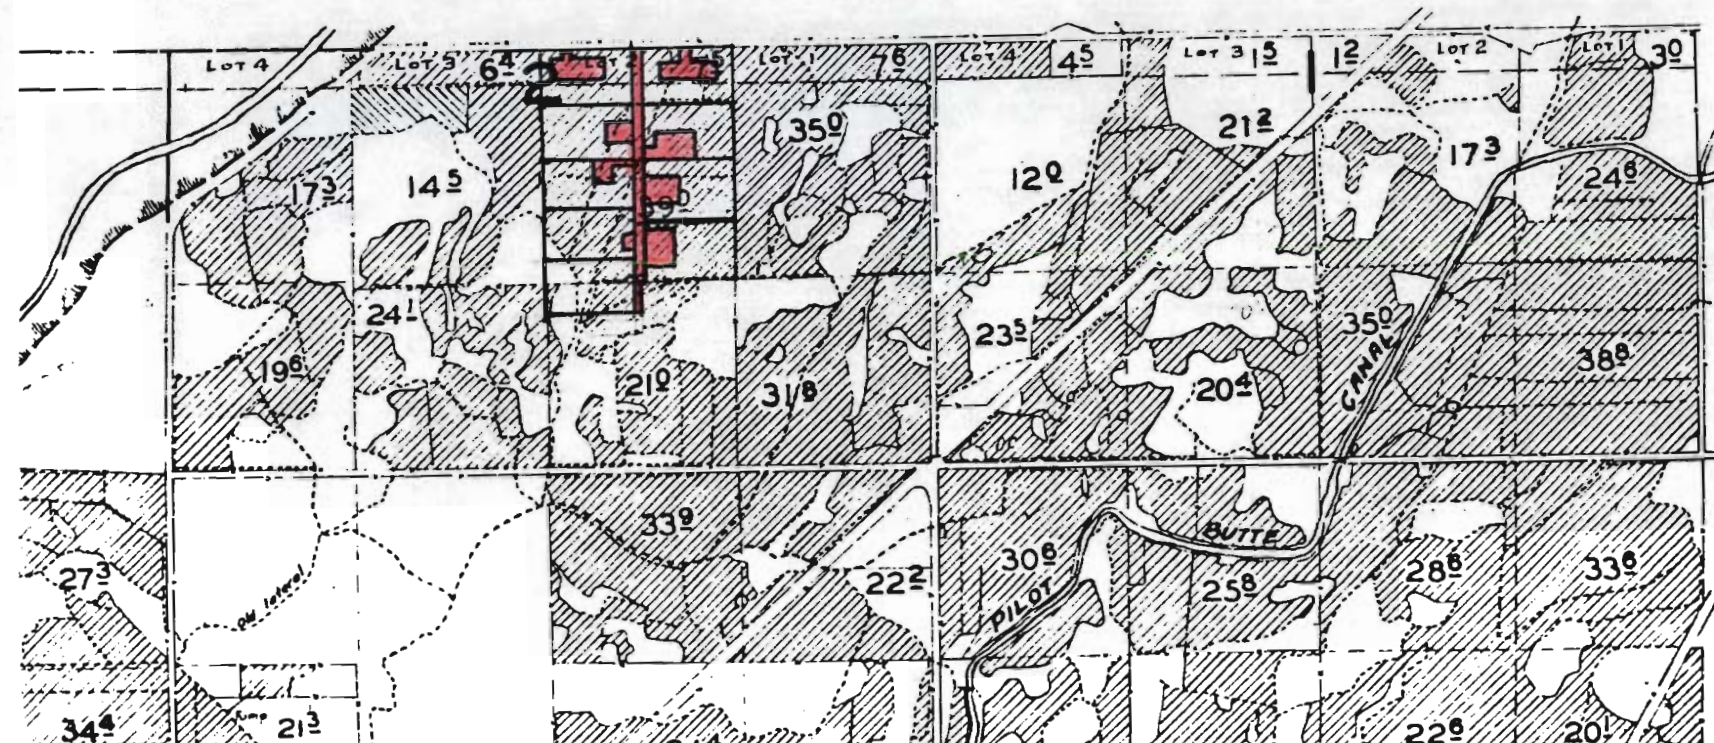

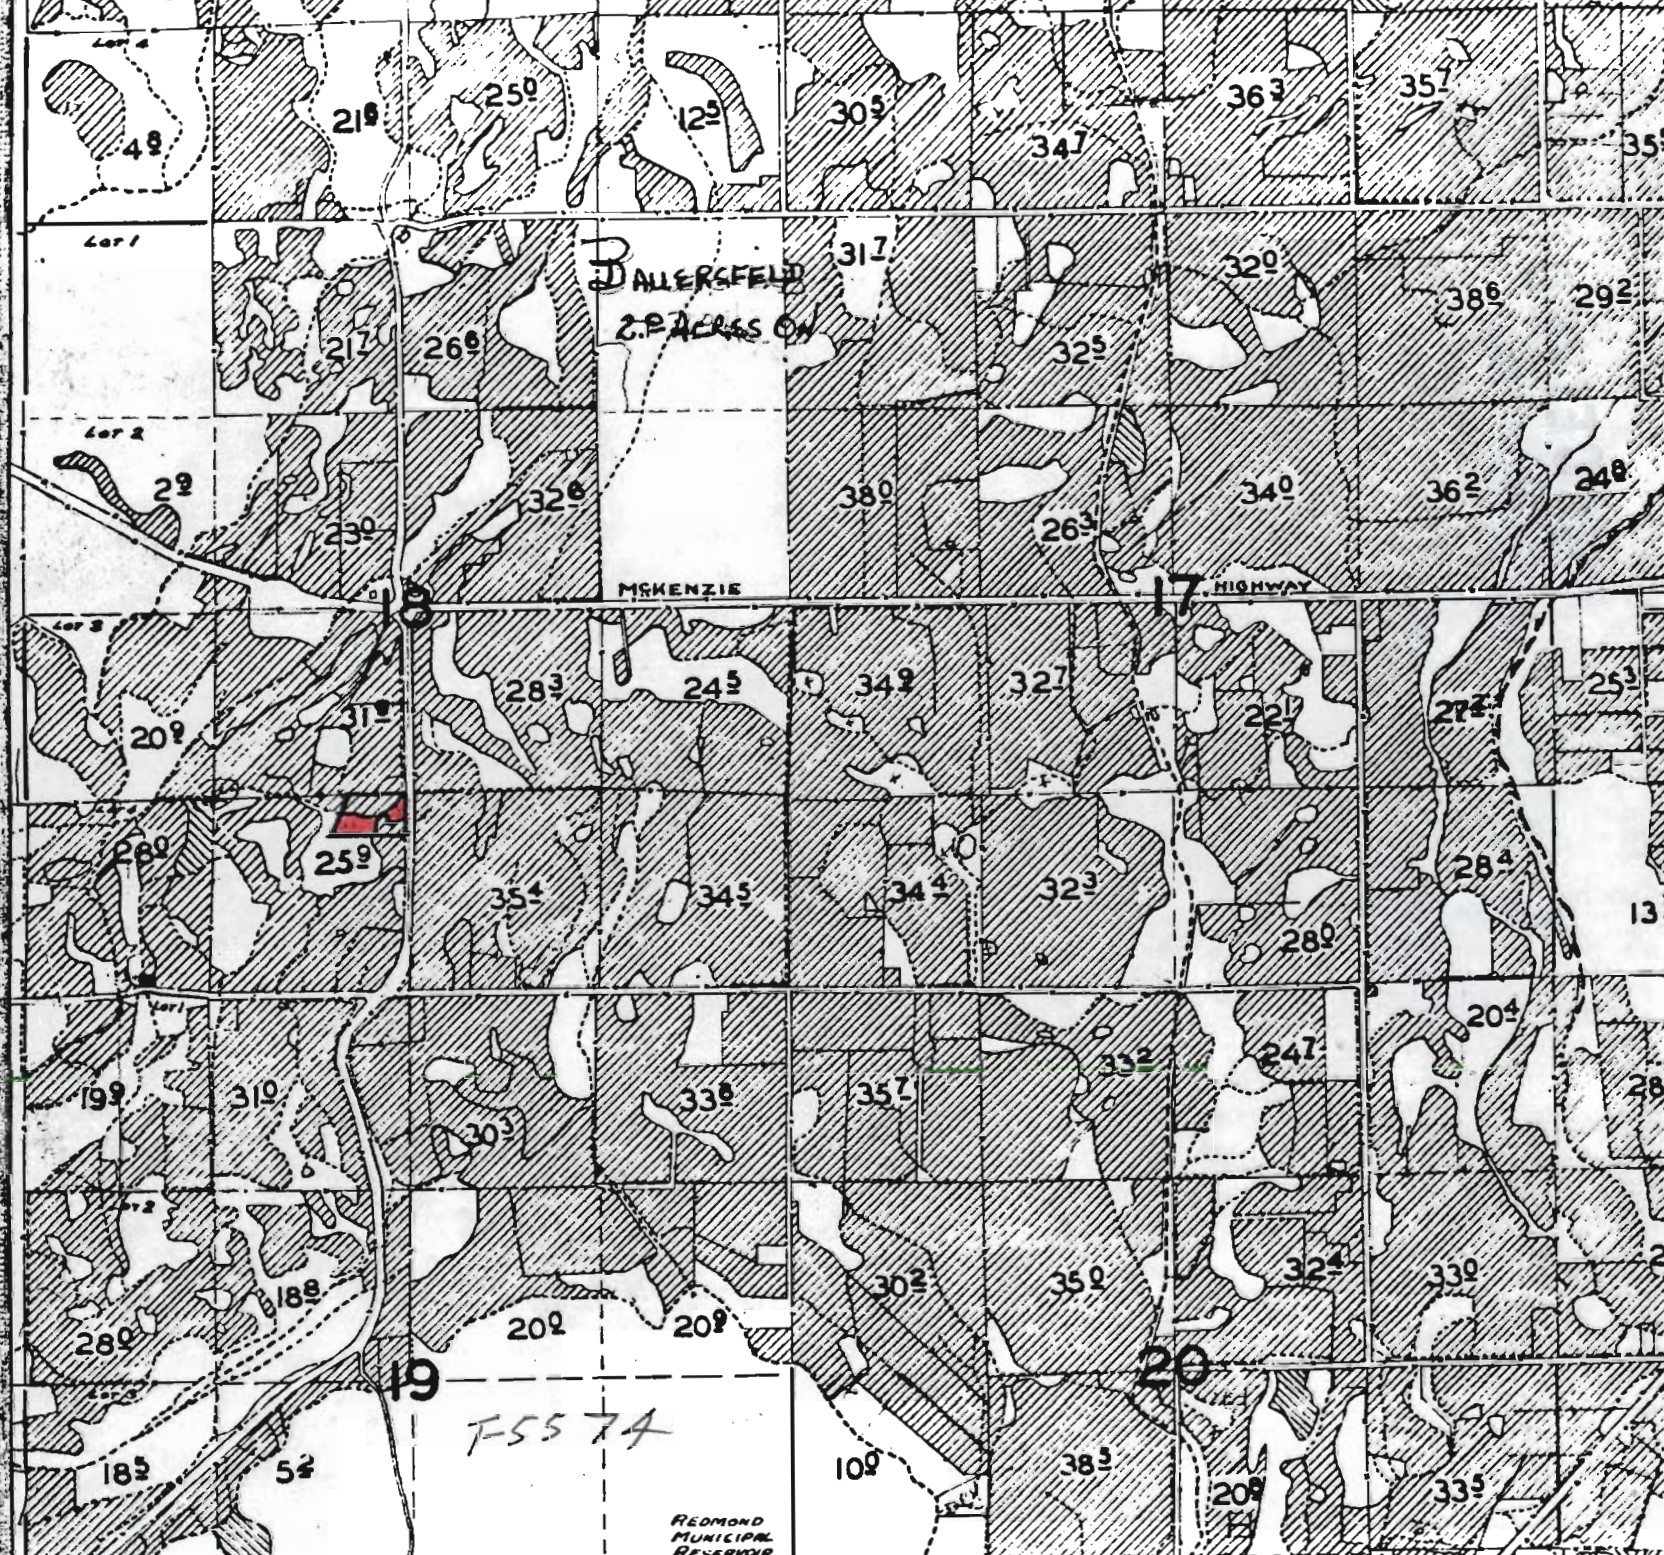

BALLERSFELD
2.2 ACRES ON

MCKENZIE

17 HIGHWAY

F-5574

REDMOND
MUNICIPAL
RESERVOIR

GE 12 EAST, W.M.

PHIL OLSON
+ 2.4 ACRES


T-5574


RECEIVED

DEC 27 1984

WATER RESOURCES DEPT
SALEM, OREGON

2.4 ACRES ON

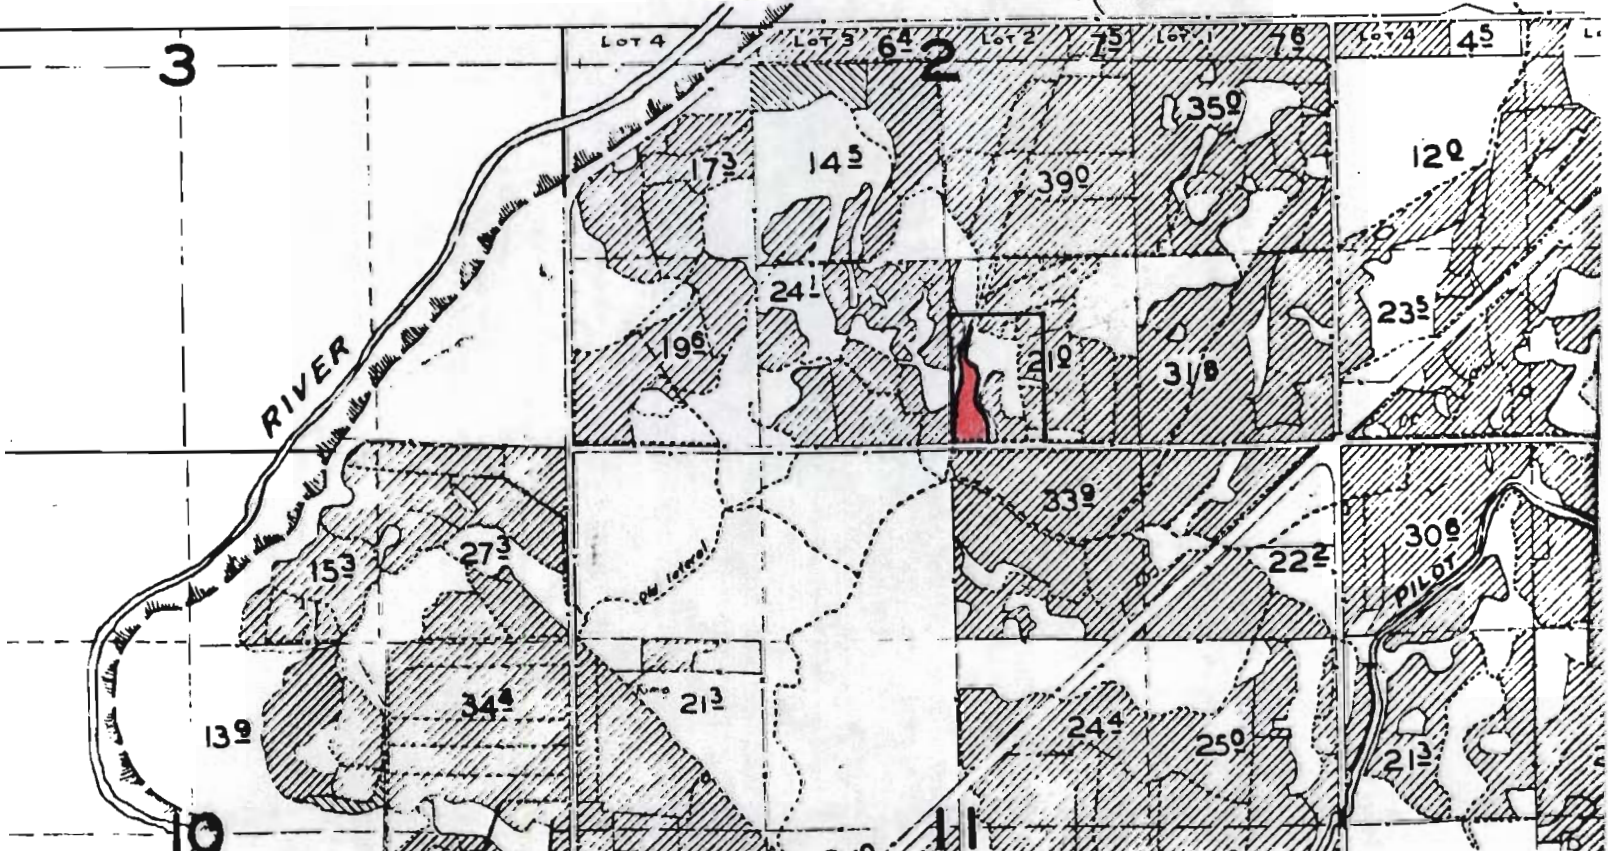

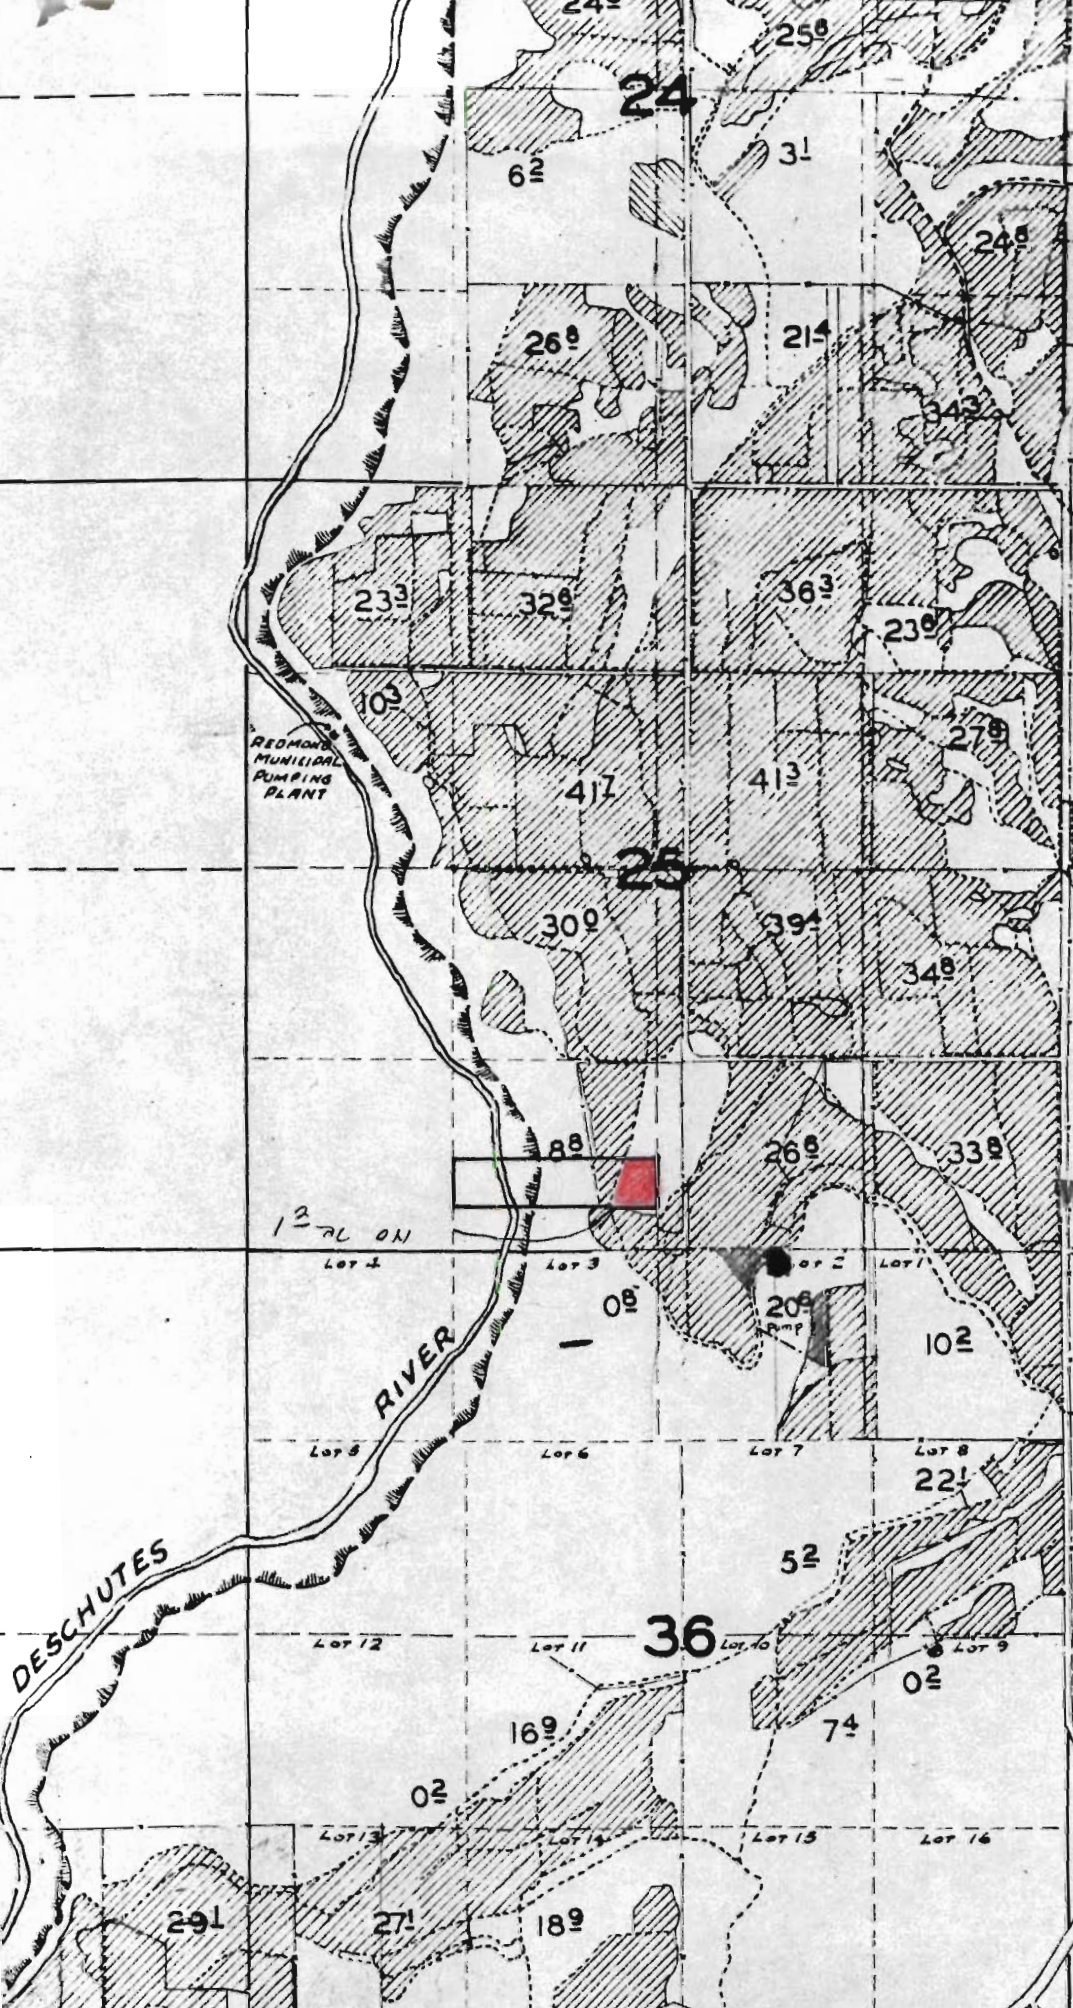


F5579

RECEIVED

DEC 27 1964

WATER RESOURCES DEPT
SALEM, OREGON

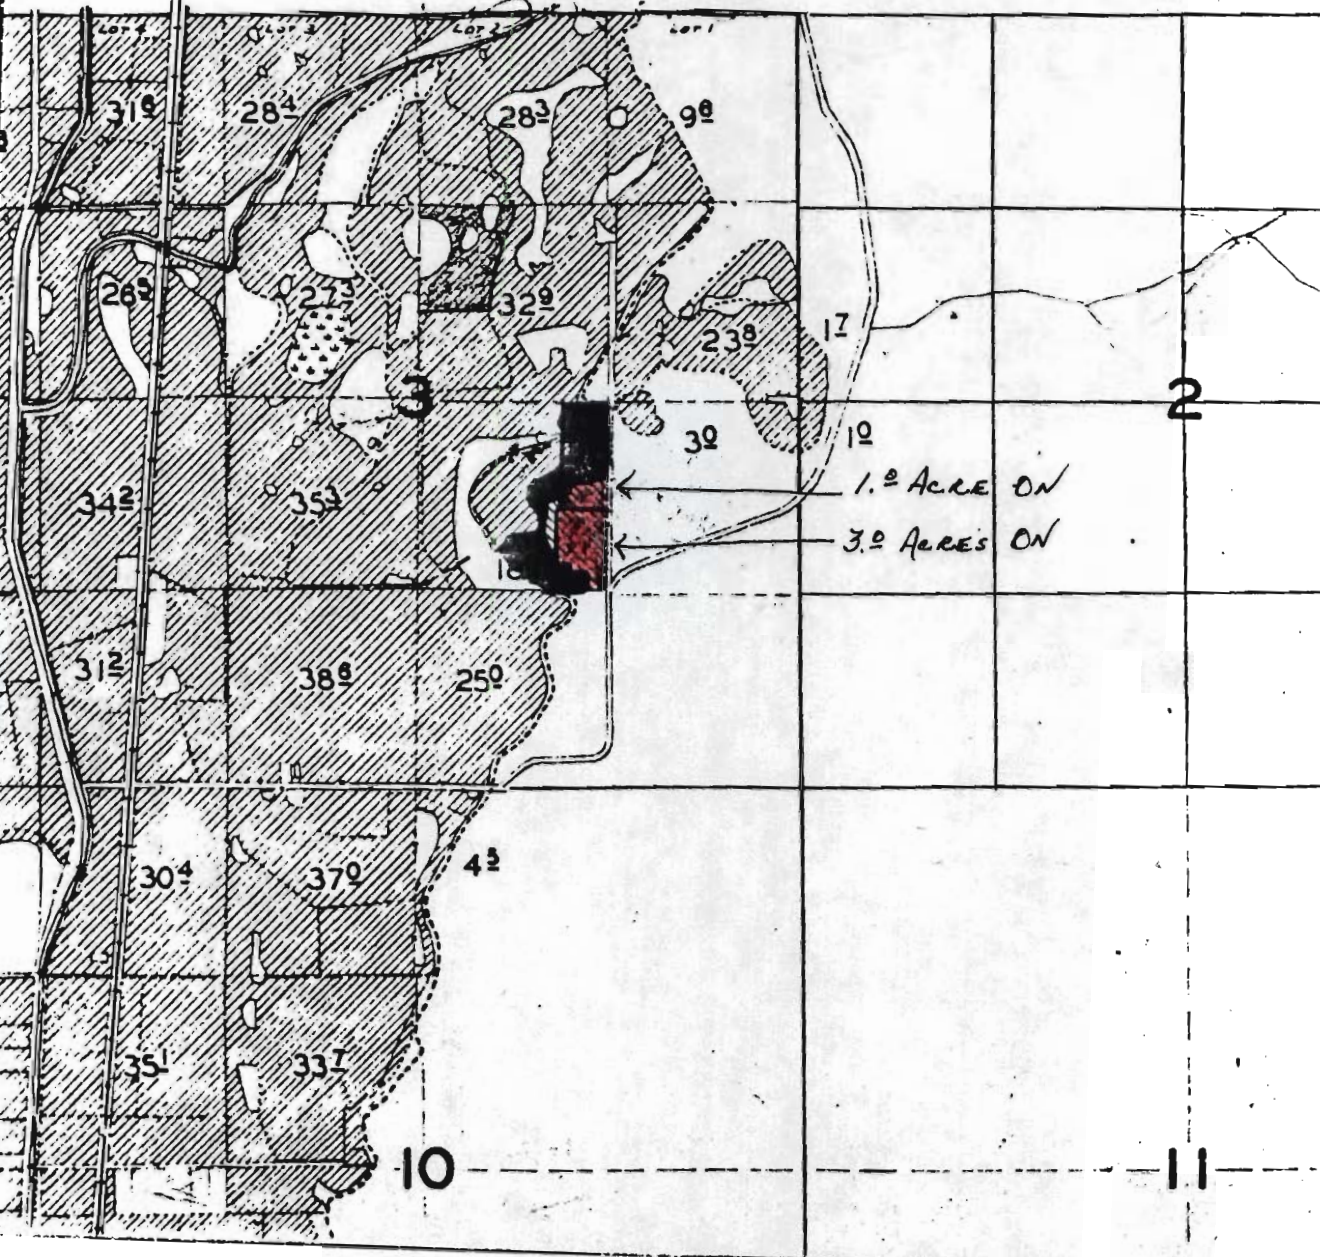

RECEIVED

F-5574

DEC 27 1984

WATER RESOURCES DEPT
SALEM, OREGON