


EXHIBIT "B" T39S R1E W.M.

T-5580

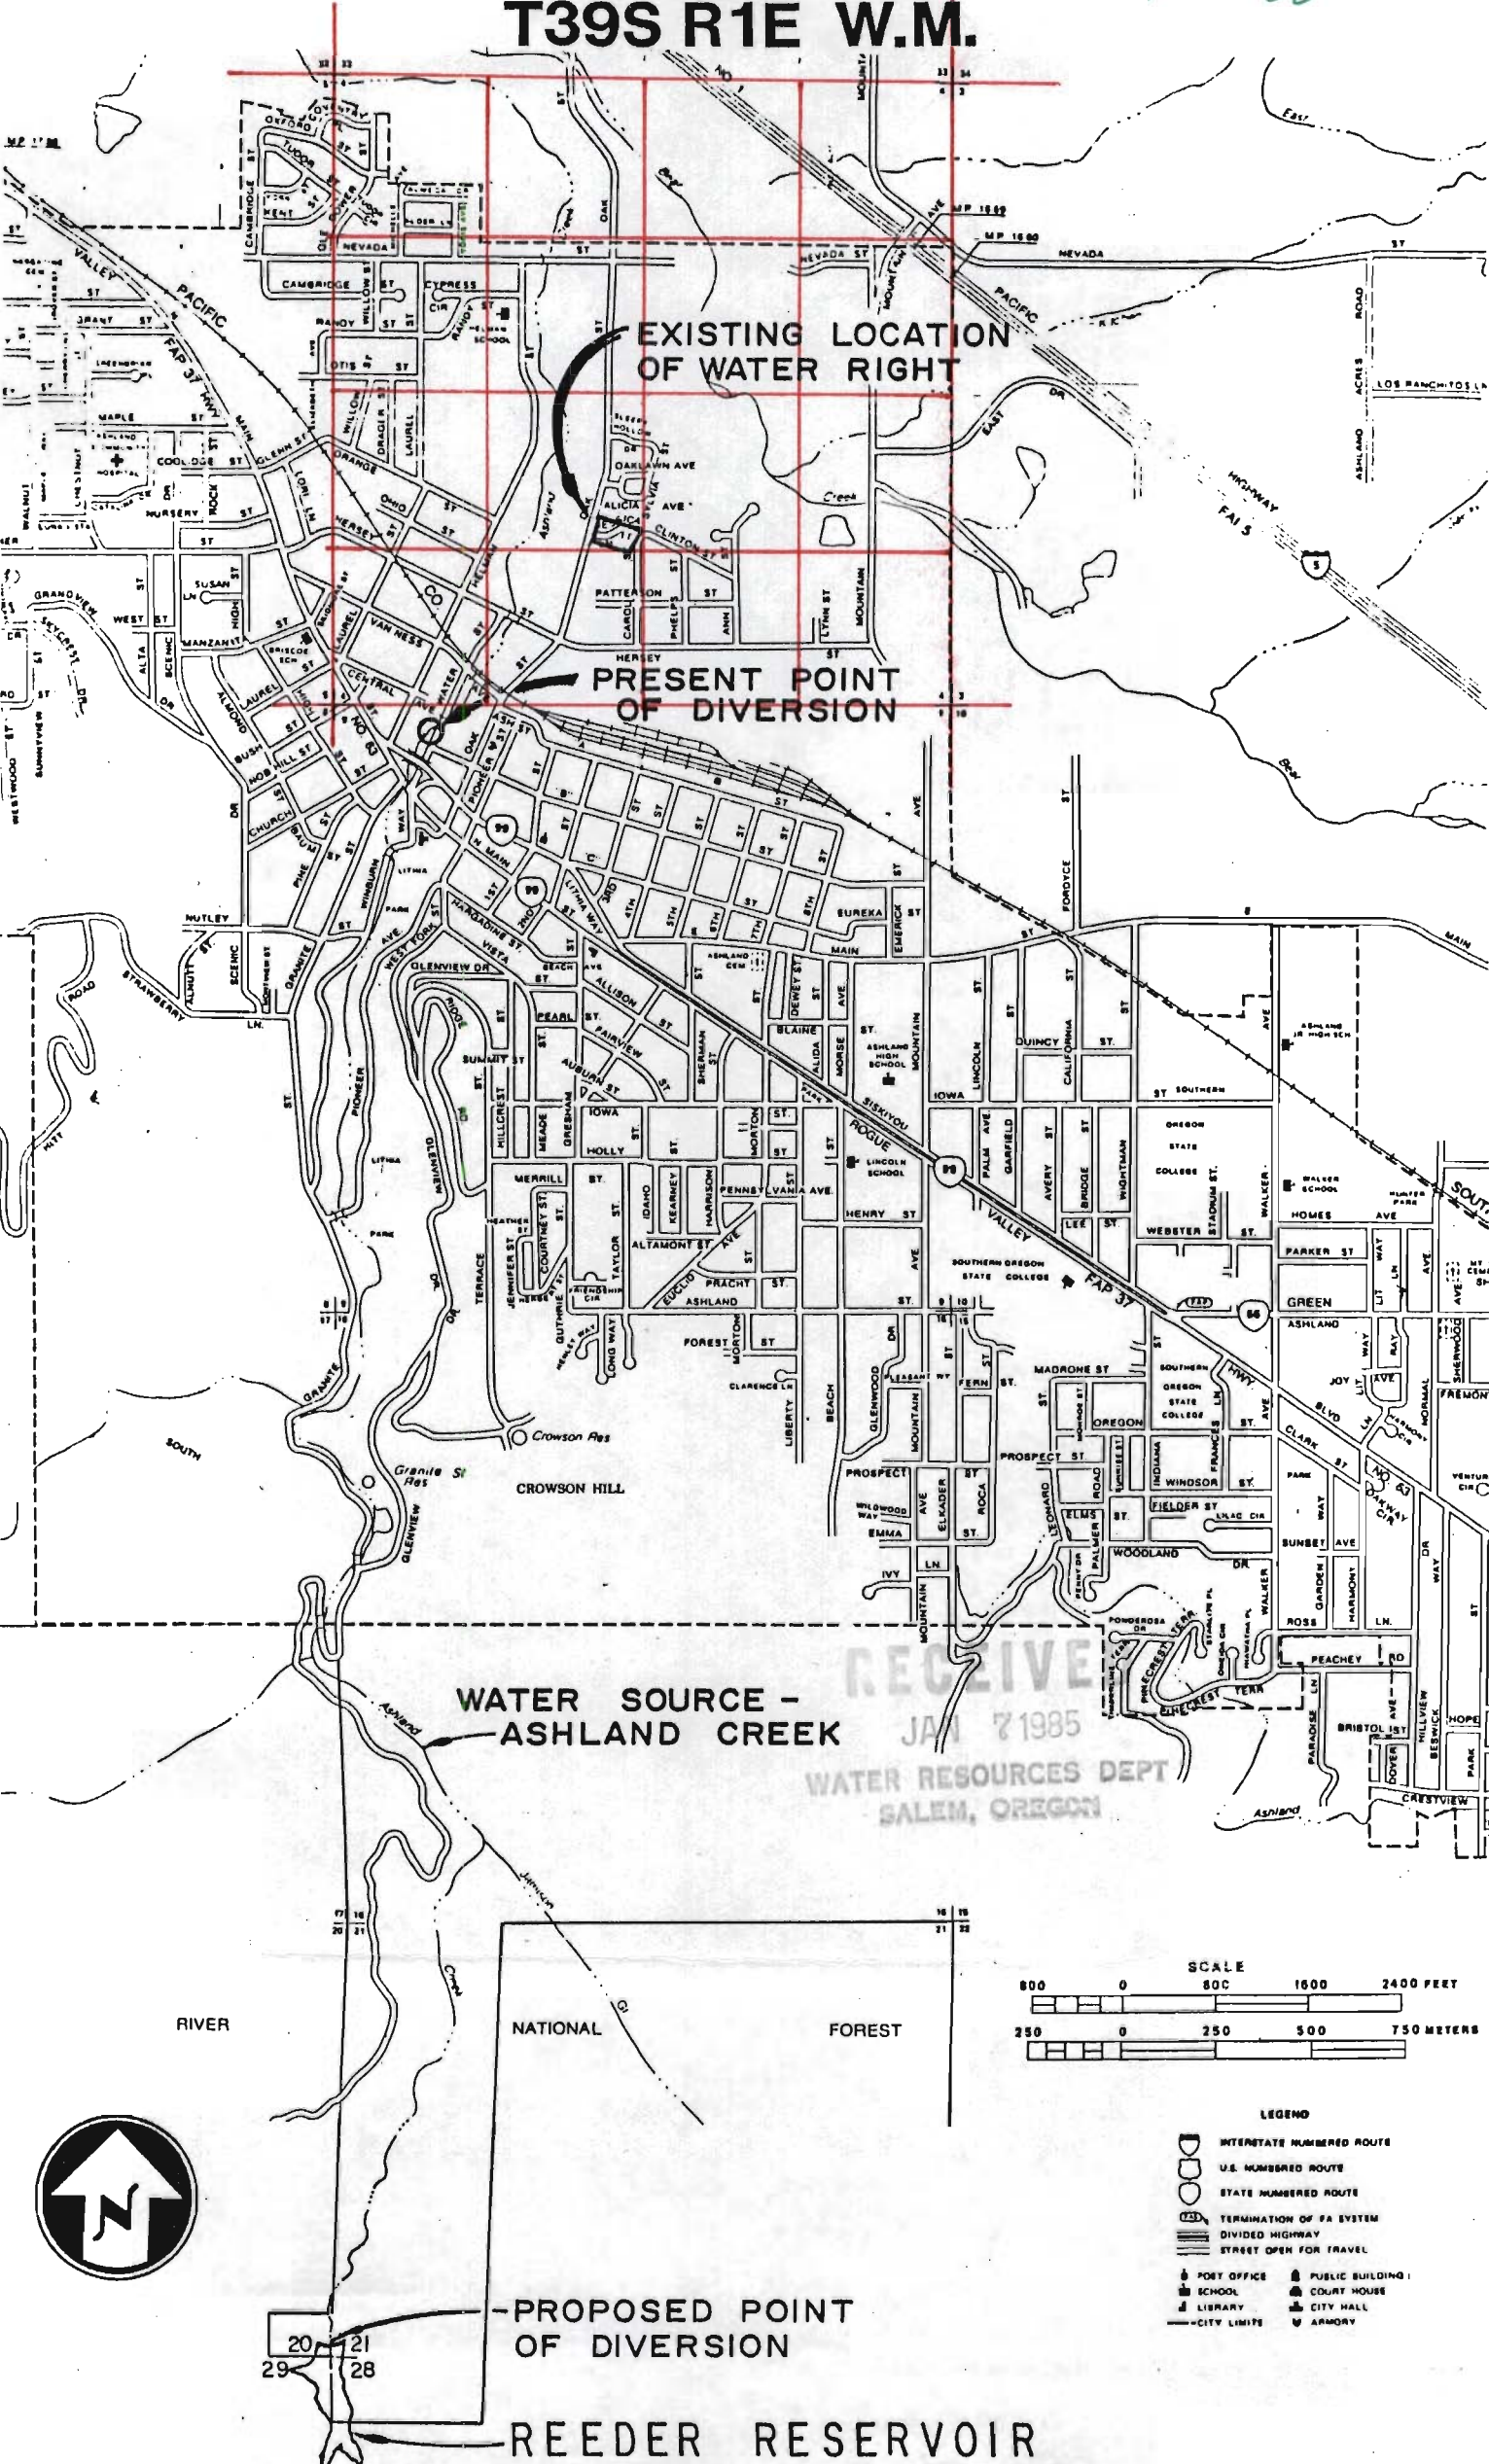

EXISTING LOCATION OF WATER RIGHT


PRESENT POINT OF DIVERSION

WATER SOURCE -
ASHLAND CREEK

PROPOSED POINT OF DIVERSION

REEDER RESERVOIR

RECEIVED
JAN 7 1985
WATER RESOURCES DEPT
SALEM, OREGON

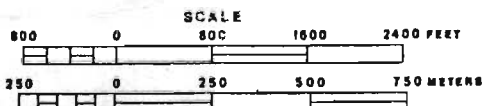

- LEGEND**
- INTERSTATE NUMBERED ROUTE
 - U.S. NUMBERED ROUTE
 - STATE NUMBERED ROUTE
 - TERMINATION OF PA SYSTEM
 - DIVIDED HIGHWAY
 - STREET OPEN FOR TRAVEL
 - POST OFFICE
 - SCHOOL
 - LIBRARY
 - CITY LIMITS
 - PUBLIC BUILDING
 - COURT HOUSE
 - CITY HALL
 - ARMORY

RIVER NATIONAL FOREST

