





RECEIVED  
JAN 14 1985  
WATER RESOURCES DEPT  
BALCON RESERVOIR

NOTE  
lands petitioned  
out of  
Baker Valley  
IRB/ylw

T-5582

HEATON

T. 8 S. R. 40 E. W. M.  
T. 9 S. R. 40 E. W. M.

DAREN SPENCER


LAWSON

CESEL

FLINT

MARKGRAF

HERBISON

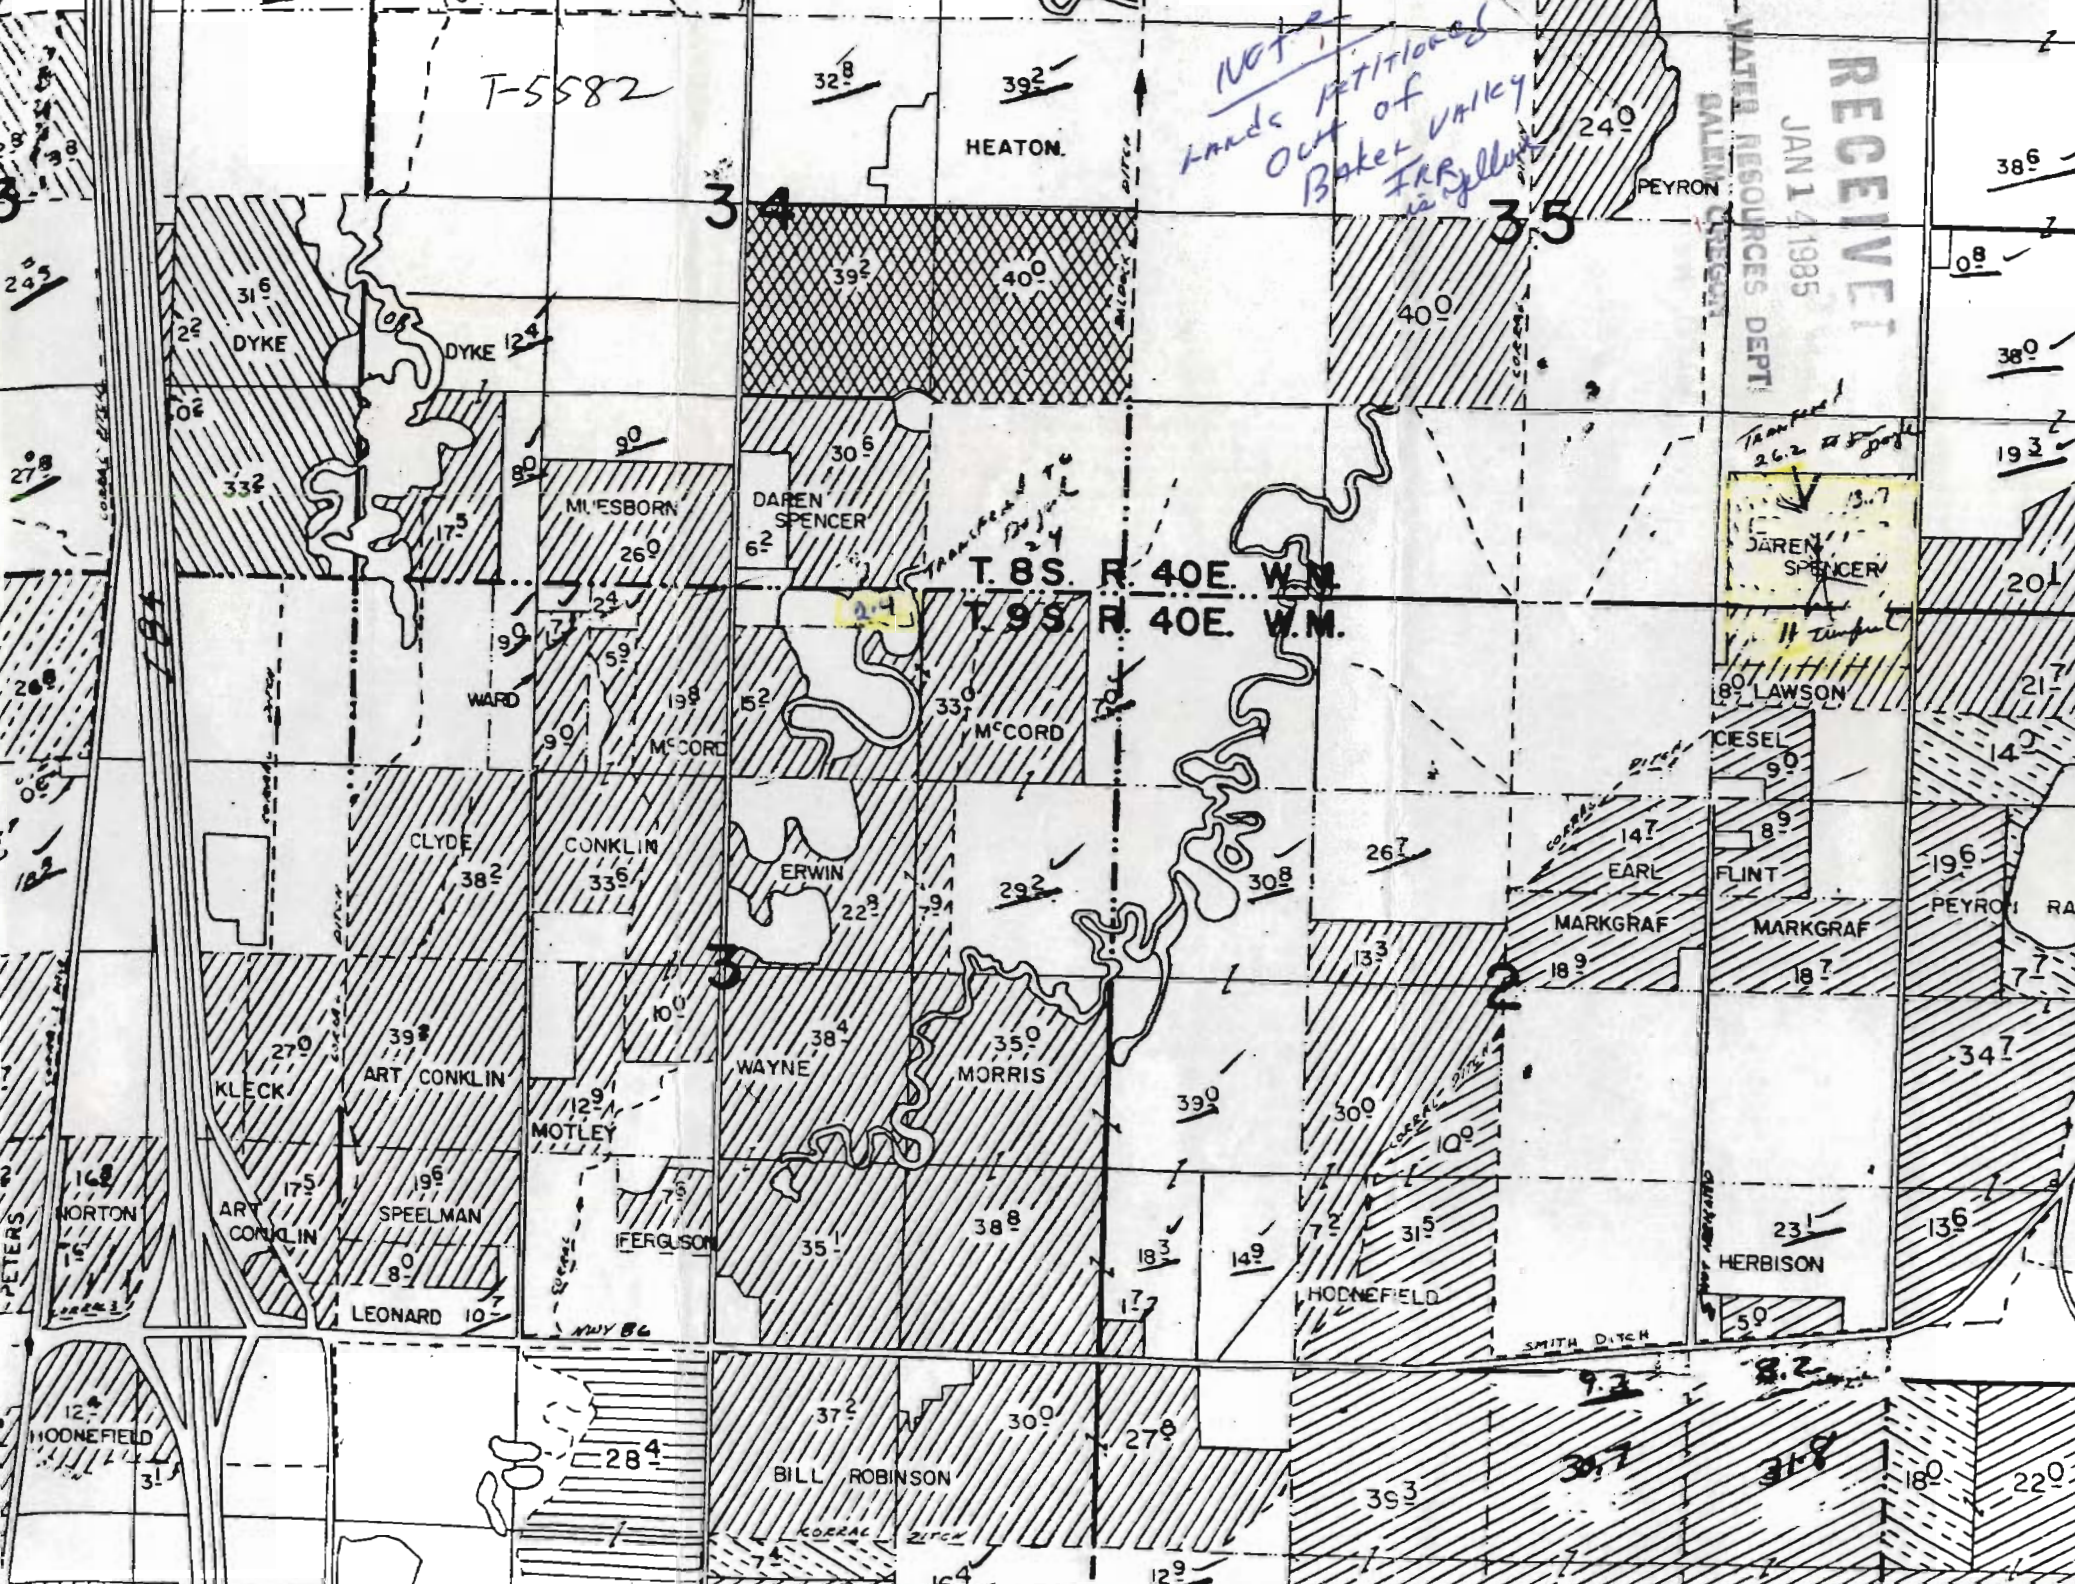




T-5582

*lands petitioned  
into Baker Valley Jr.  
in red*

RECEIVED

MAR 25 1985

WATER RESOURCES DEPT  
SALEM, OREGON

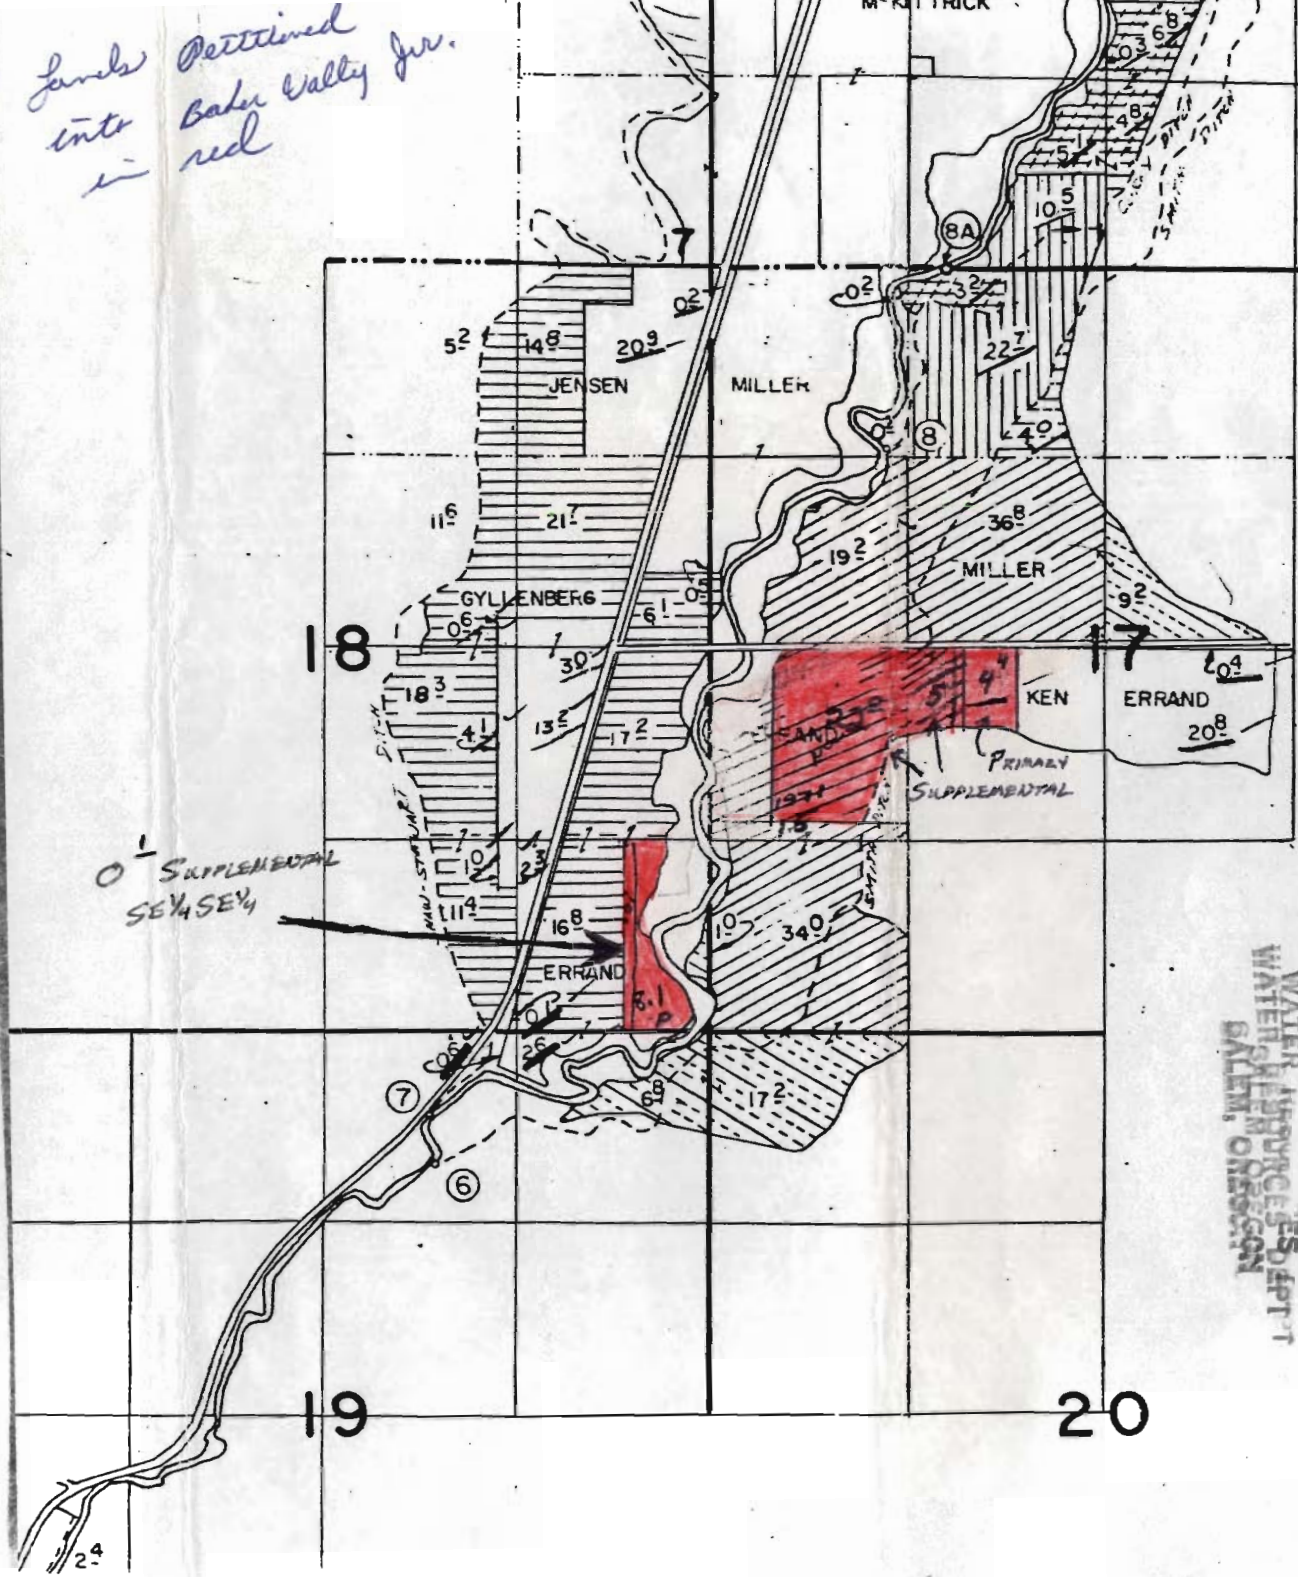

WATER RESOURCES DEPT  
SALEM, OREGON

JAN 14 1985

RECEIVED