


T. 4N., R. 28E., W.M.

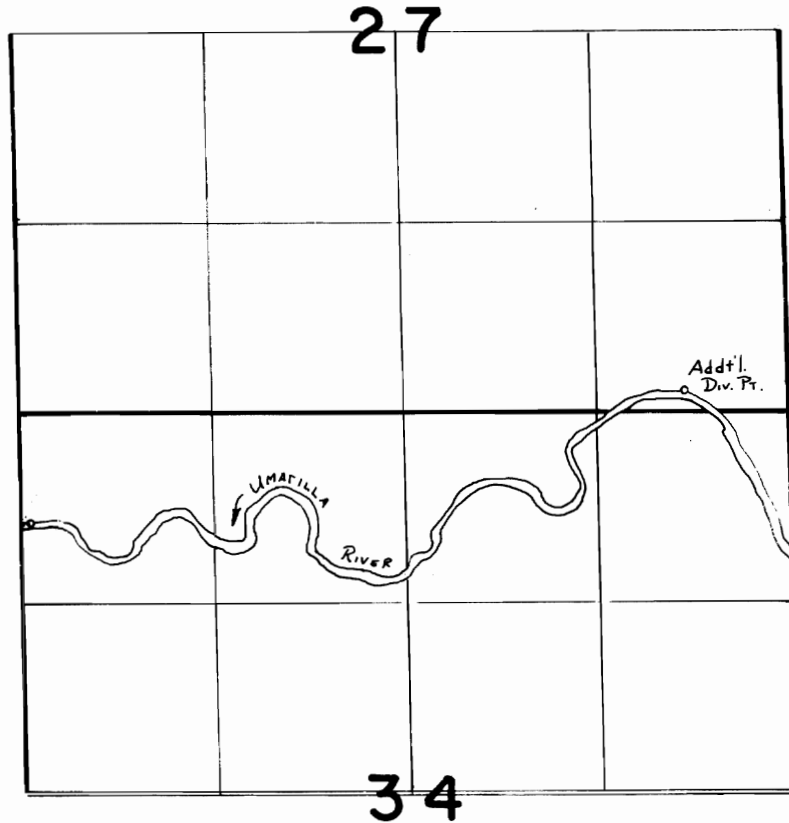

Add'l Div. Pt. LOCATED 140' N. & 710' W. FROM SE CORNER SECTION 27

FINAL PROOF SURVEY
UNDER

TRANSFER 5583, 5584, 5585, 5586

IN NAME OF

J. R. SIMPLOT CO.

Surveyed 4-2-1985, by V. L. Christ



SCALE: 1" = 1320'

SPECIAL ORDER V. 39 P. 101
103
105
99