

RECEIVED


FEB 6 - 1985


WATER RESOURCES DEPT  
SALEM, OREGON

T-5587

3.39 ACRES ON

4" = 1 MILE APPROX.

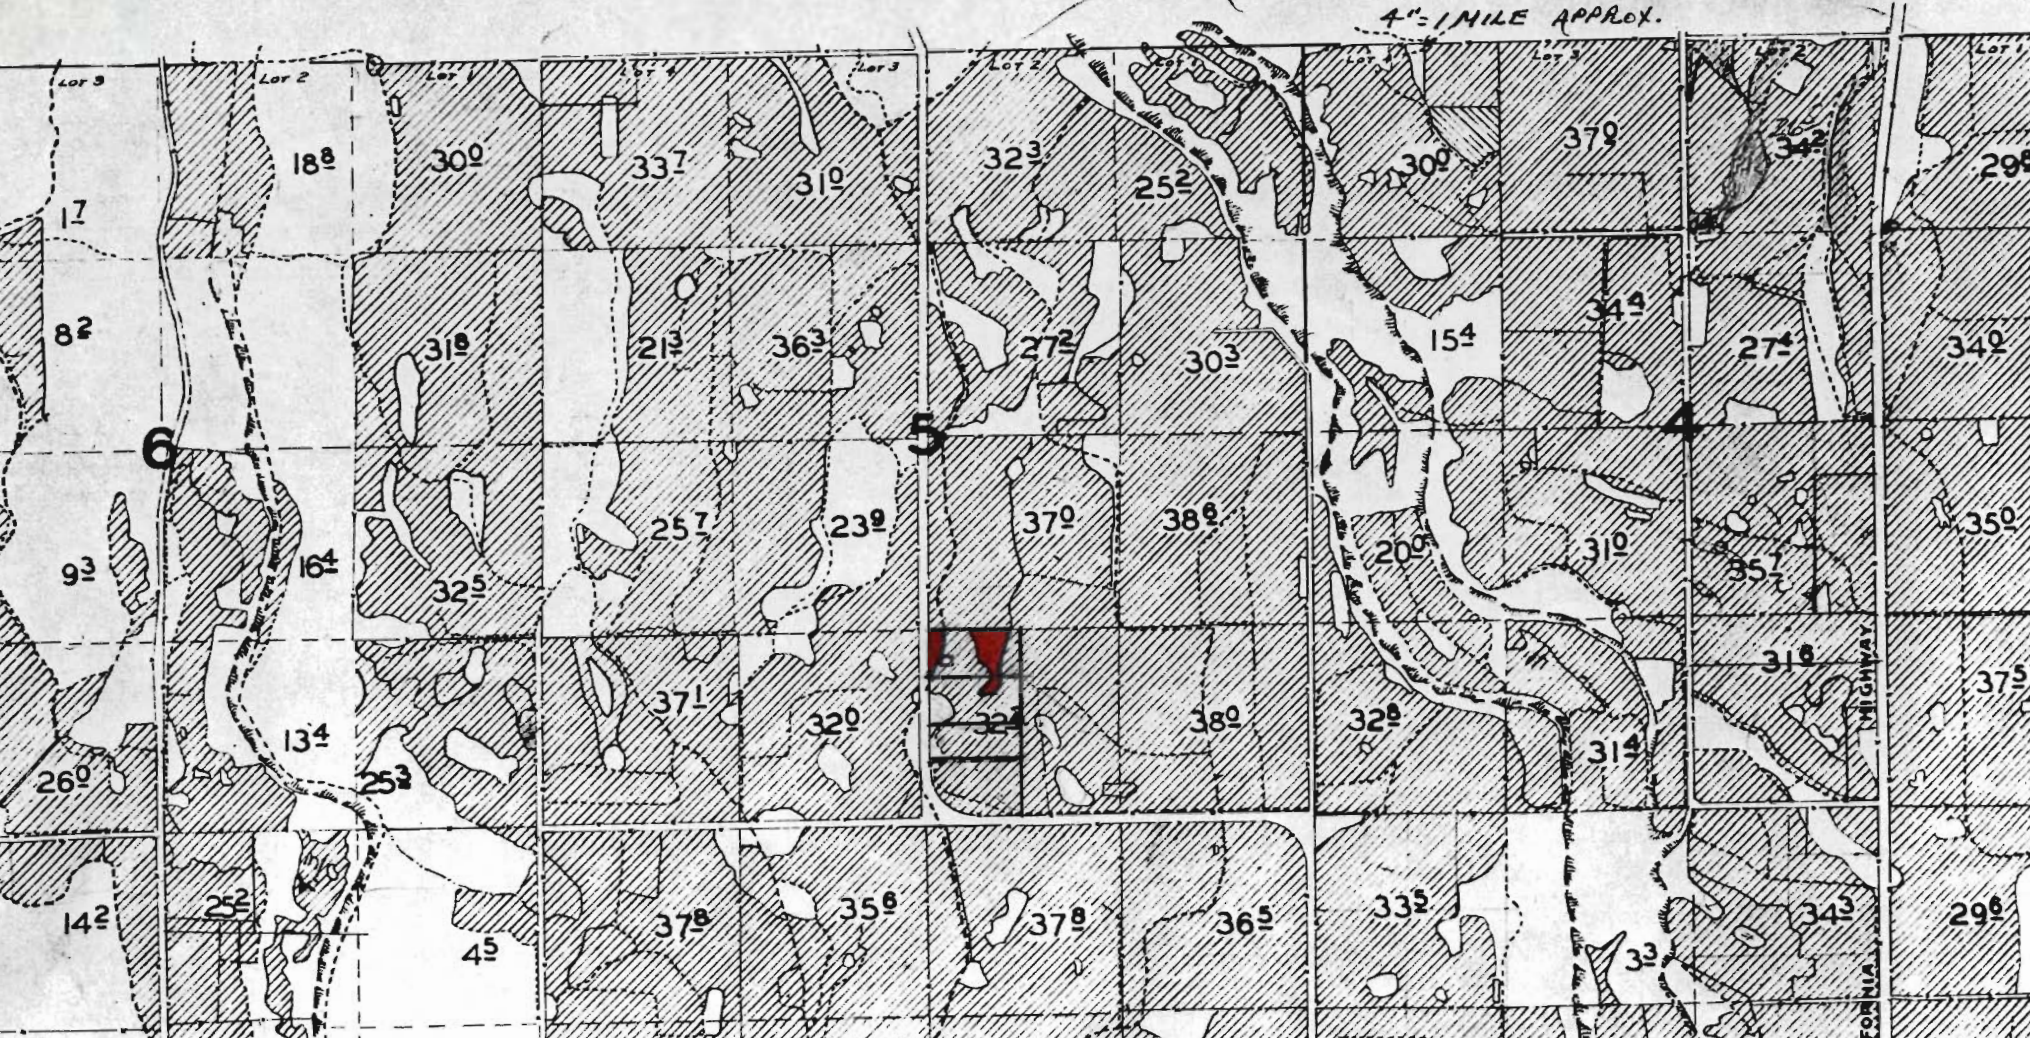

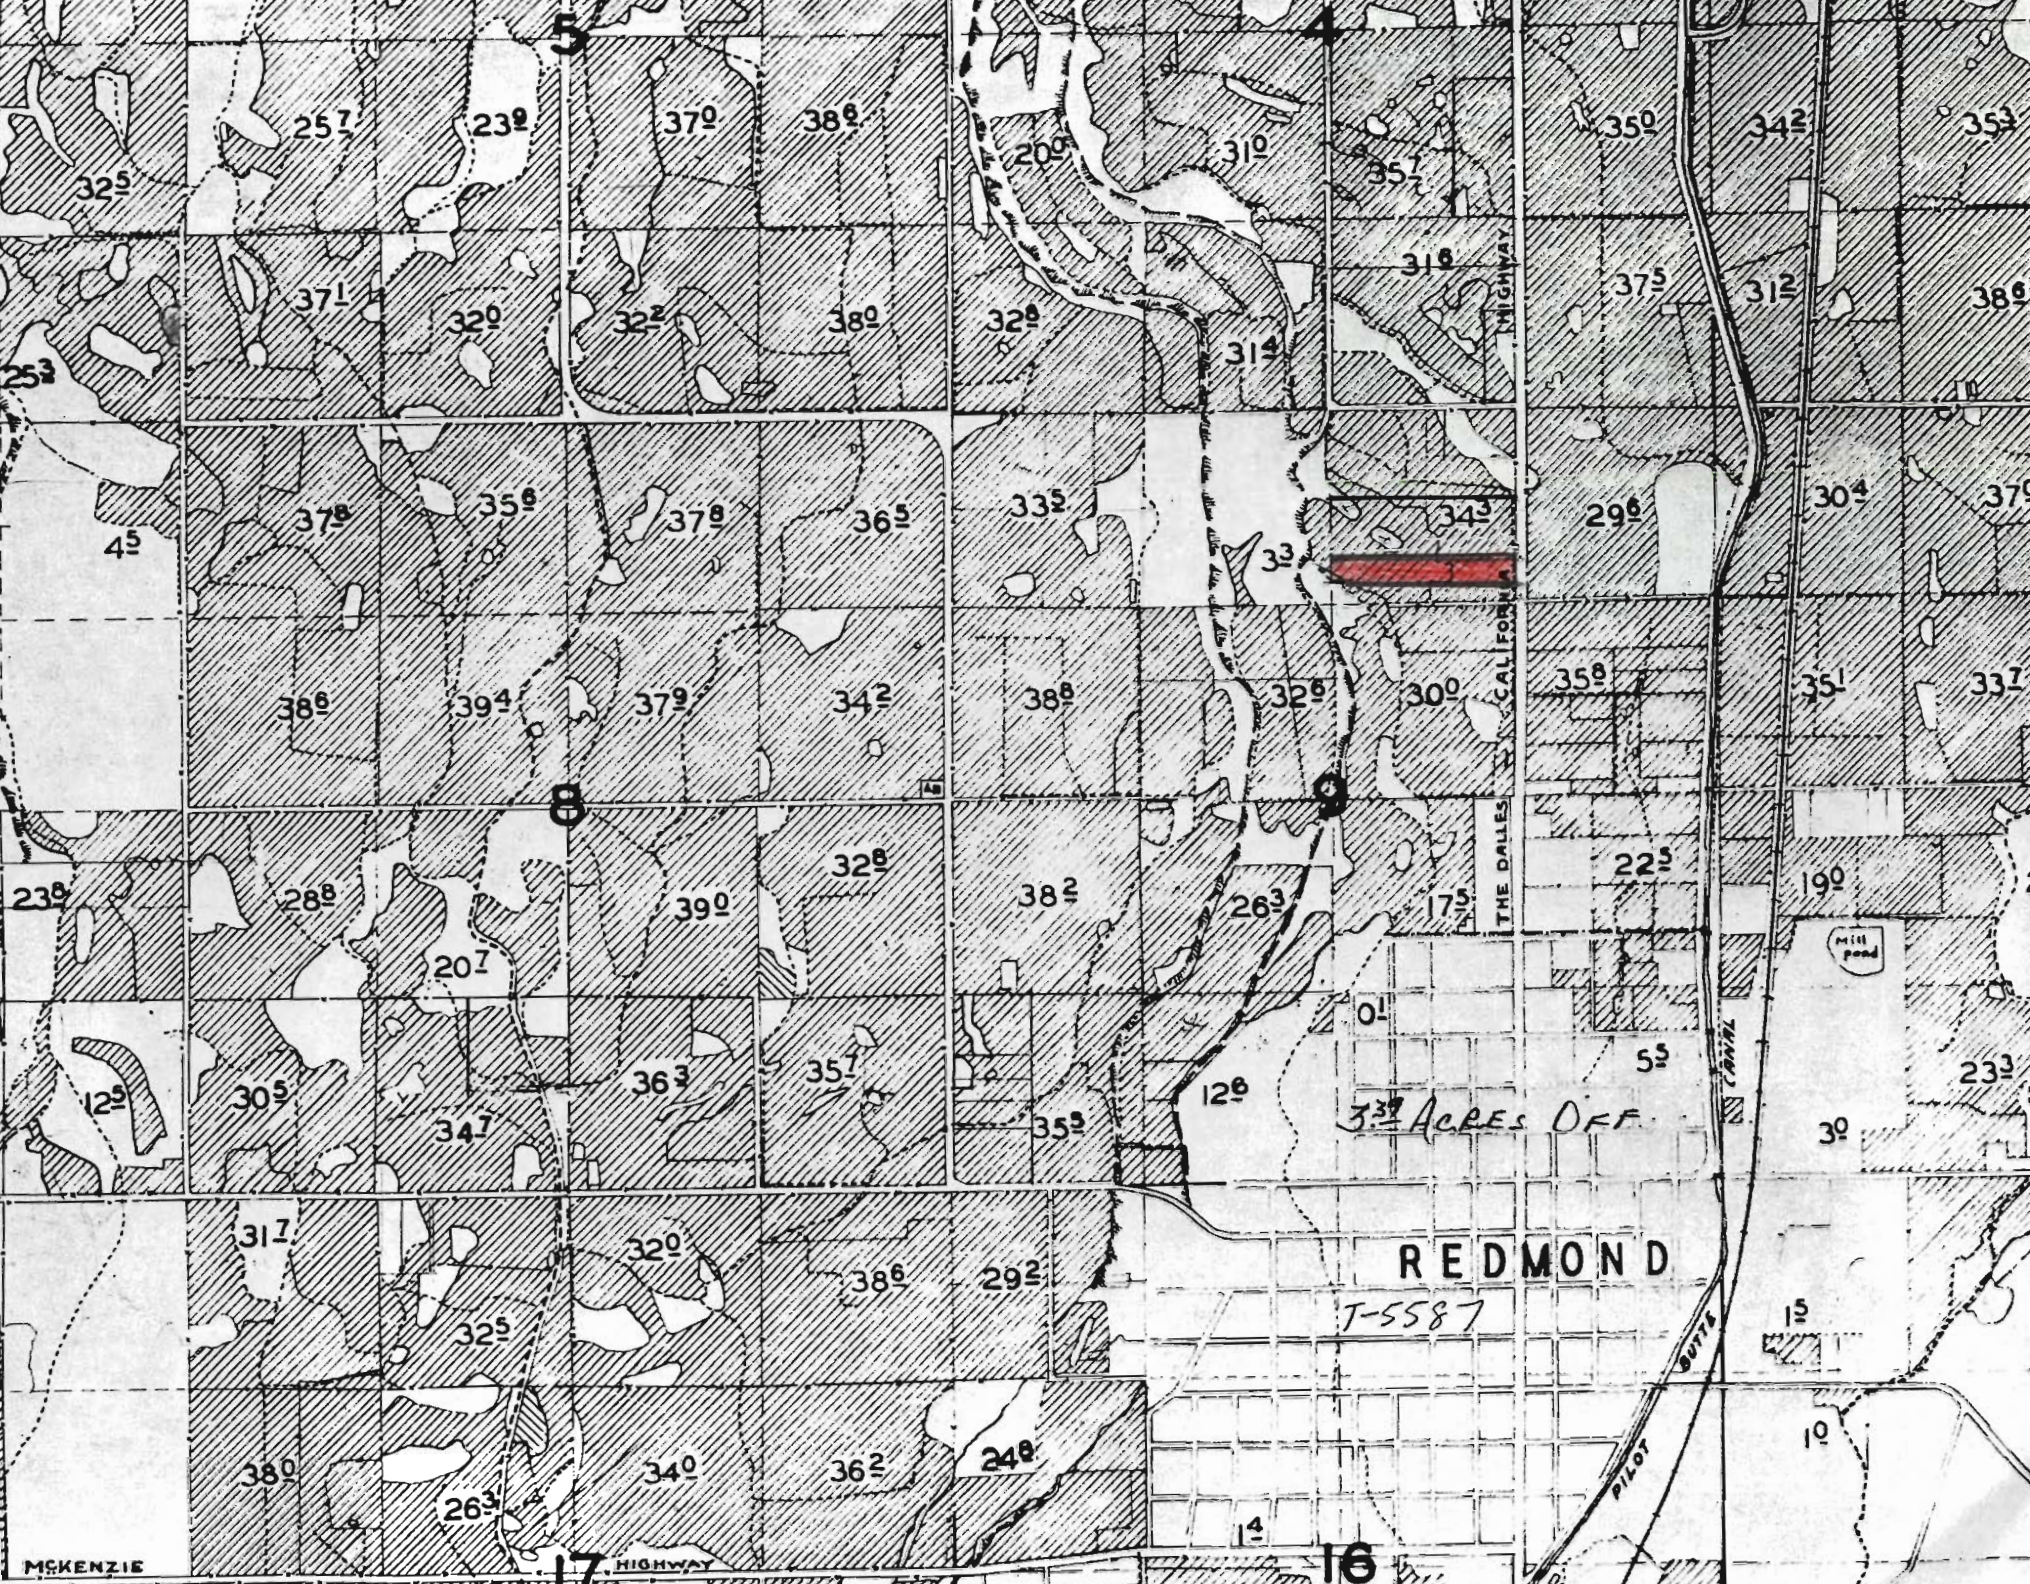

5

4

8

16

17

MCKENZIE

HIGHWAY

REDMOND

T-5587

33<sup>3</sup> ACRES OFF

MILL POND

THE DALLES CALIFORNIA HIGHWAY

PILOT BUTTE CANYON