

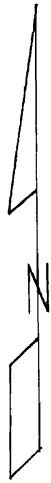


TOWNSHIP 15 SOUTH, RANGE 10 EAST, W.M.

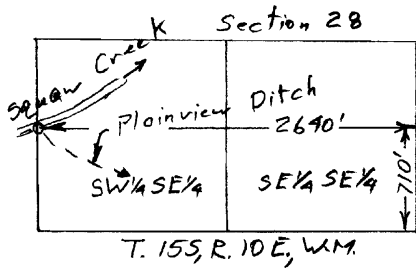


Scale 1" = 1320'

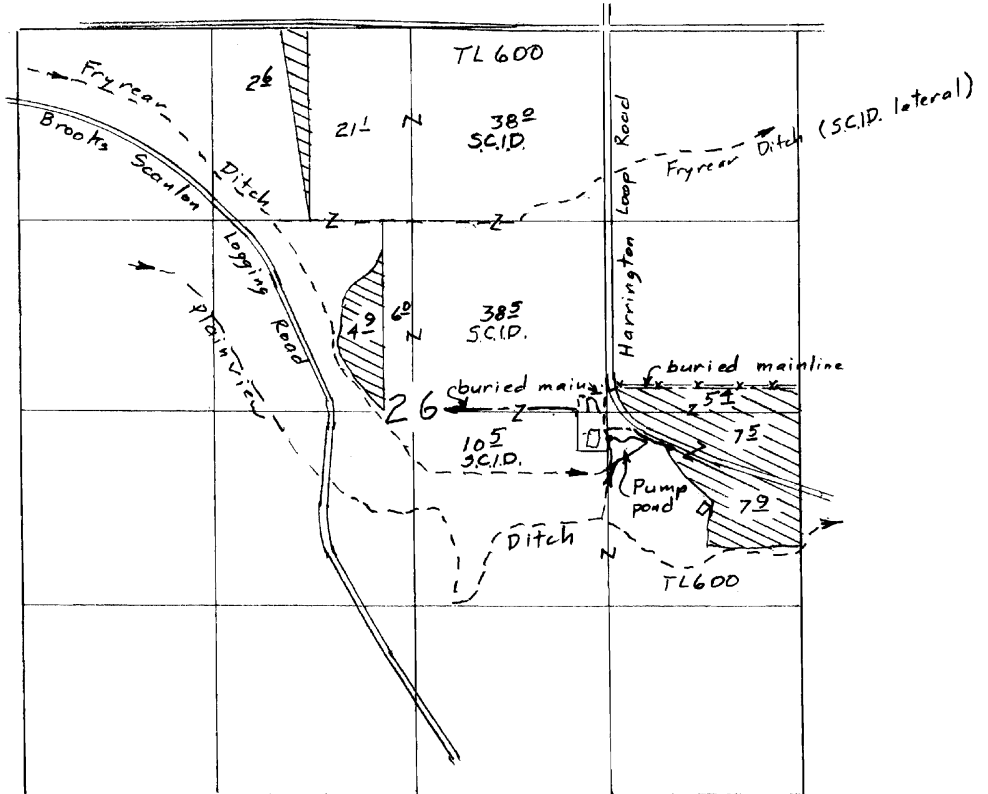

⊙ 1904 Plainview Ditch transferred in 28³ acres

Claim of Beneficial Use Map
for
Weldon Wankier
(Black Diamond Ranch)

T- 5591

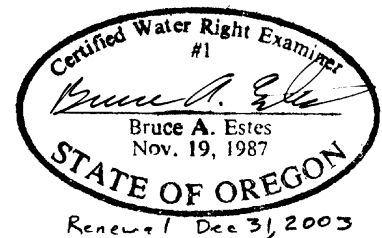

This map is for the purpose of locating a water right only and has no intent to provide legal dimensions or the location of property lines.

ESTES SURVEYS, LLC

PO Box 17519
Salem, OR 97305-7519
(503) 585-7593

60382 Arnold Rd
Bend, OR 97702
(541) 382-7391