


T.14S.,R.12E.,W.M.

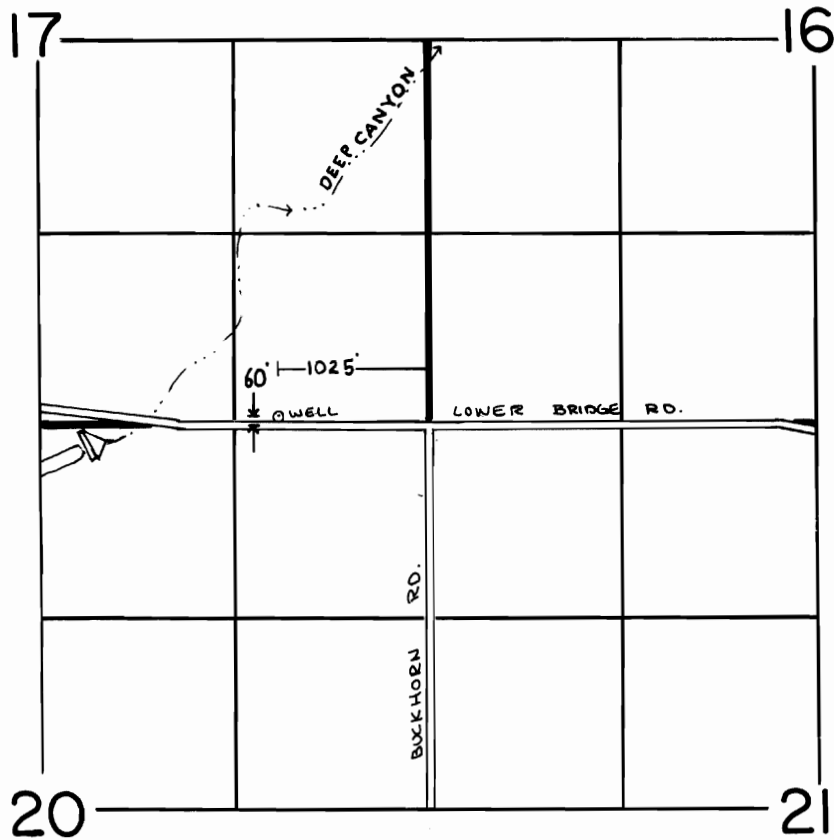

SCALE : 1" = 1320'

**FINAL PROOF SURVEY**  
UNDER

TRANSFER NO. 5592

IN NAME OF

**FRED G. & JUDY E. GUNZNER**

Surveyed JULY 17, 1985, by LESLIE OLSON...