

0.8

0.9

2866

2862
MADRAS-
JEFFERS
AIRPORT

25.1

F-5601

11.6

2867

2863

2868

10.6

11.4

35

SENW
35-10-13
22.0 ACRE LESSEES
RIGHTS

MADRAS NIN.
GOLF & COU

2870

2869


RECEIVED

MAR 1 1985
WATER RESOURCES DEPT.
SALEM OREGON



285

9.3

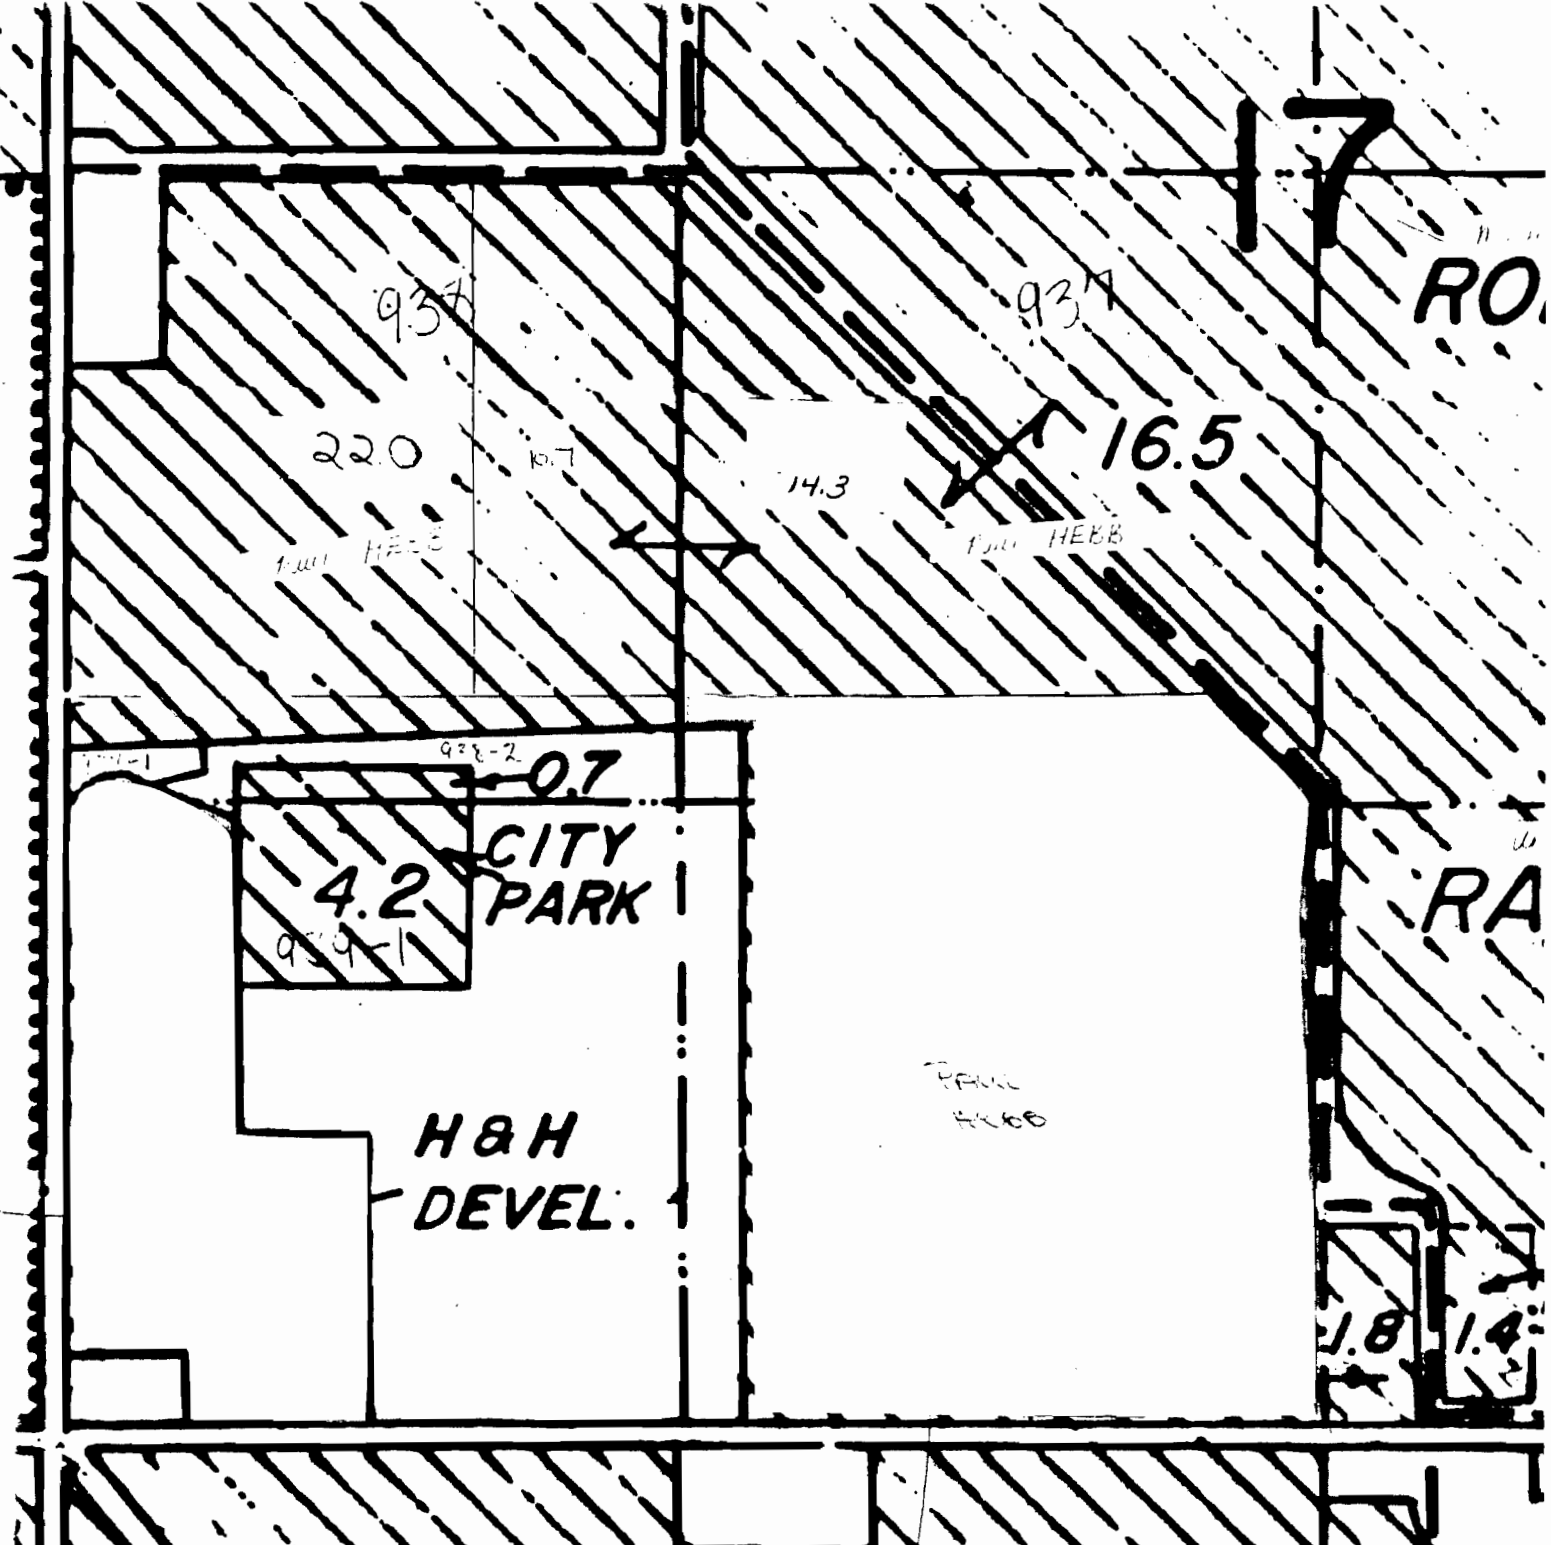

HEBB 7.1000
 TRANSFERRED 041
 1984 & 1985

RECEIVED

MAR 1 1985
 WATER RESOURCES DEPT.
 SALEM, OREGON

T-5601

Section 17
 Township 12
 Range 13

FROM