

TOWNSHIP 3 N., RANGE 27 E., W.M.


FINAL PROOF



TRANSFER 5610
TRI-SET, INC.



SCALE: 1 inch = 1320 Feet

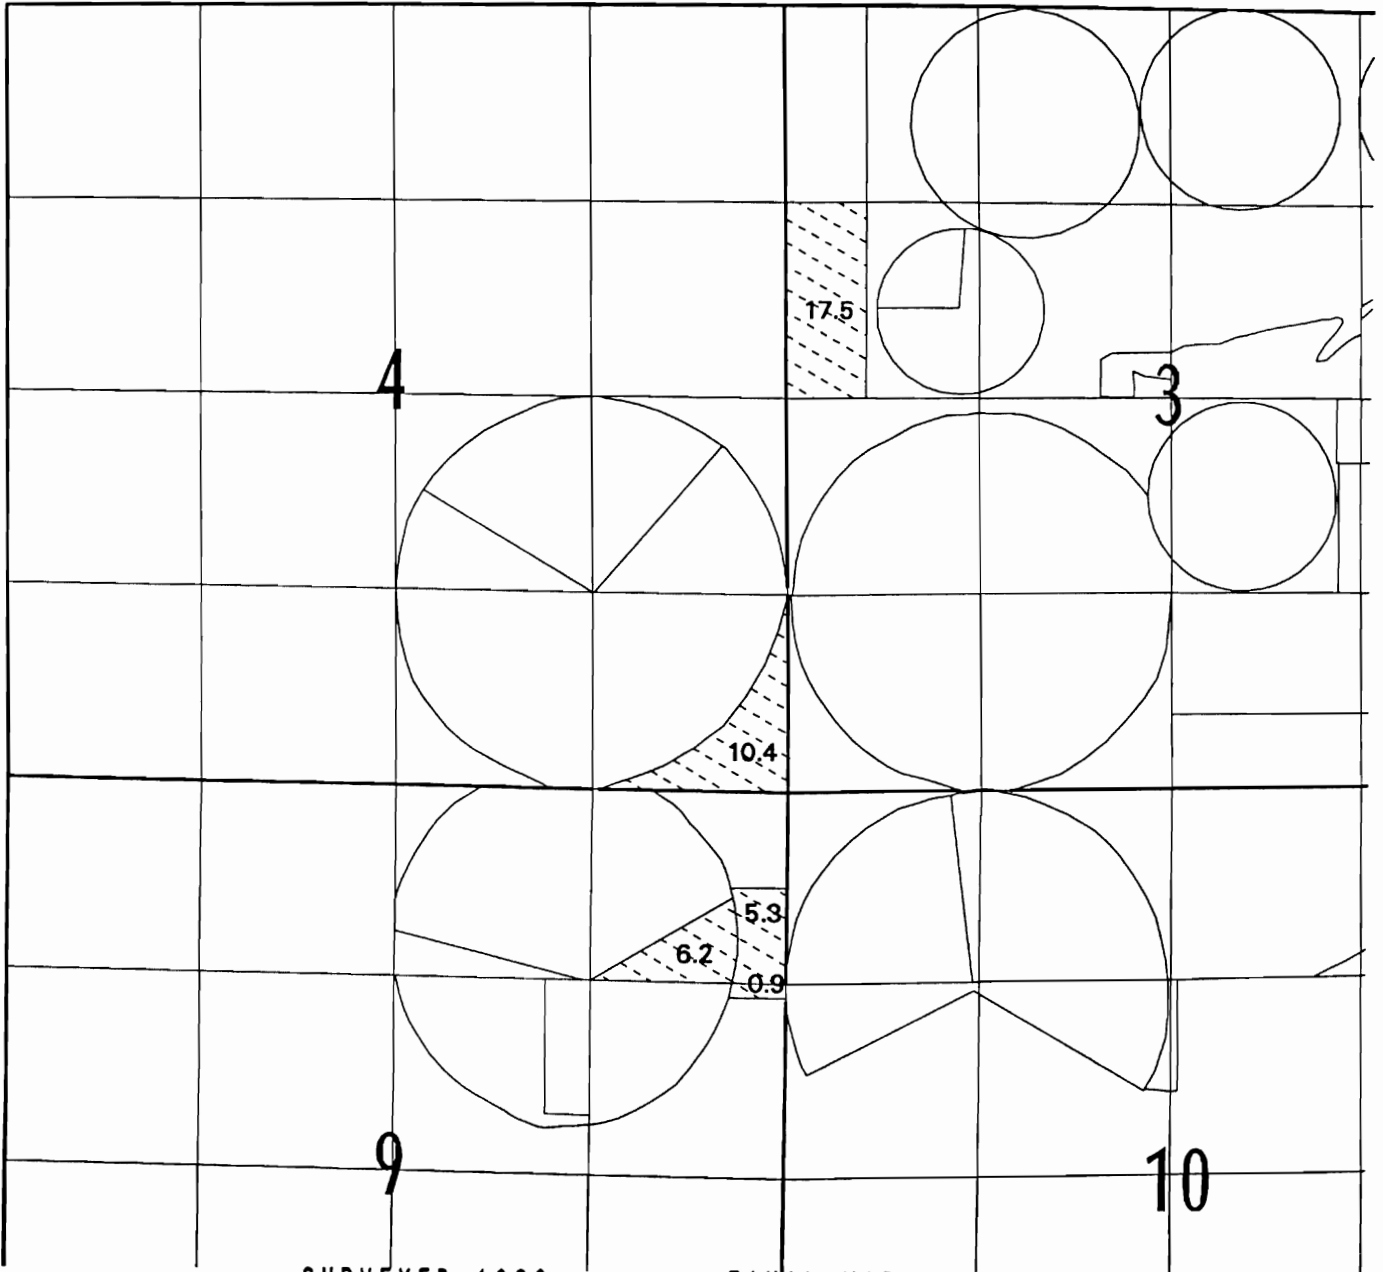

SURVEYED 1989

FINAL MAP - SEPT 2001