



# T.14S., R.15E., W.M.

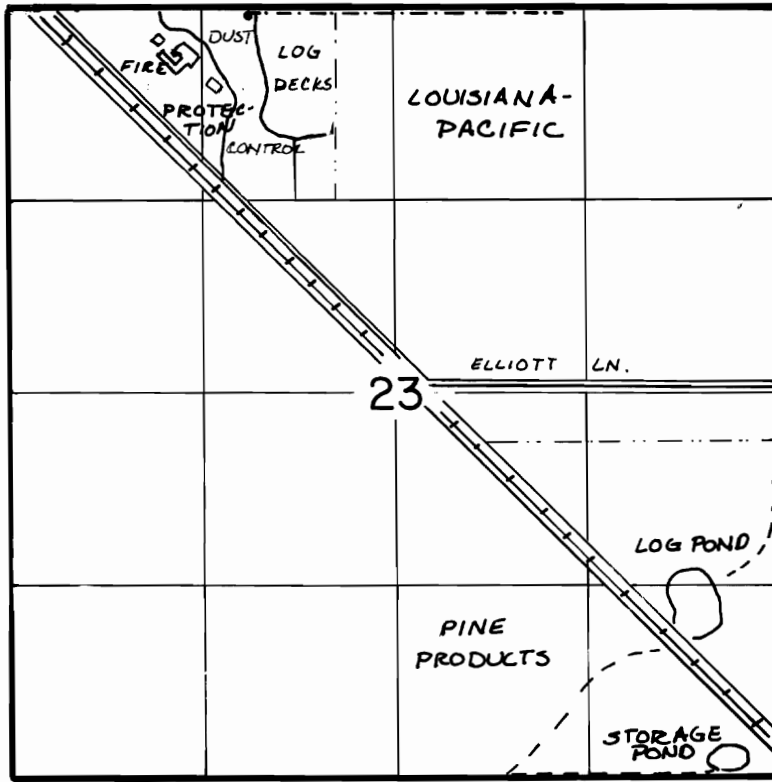

# T.15S., R.16E., W.M.

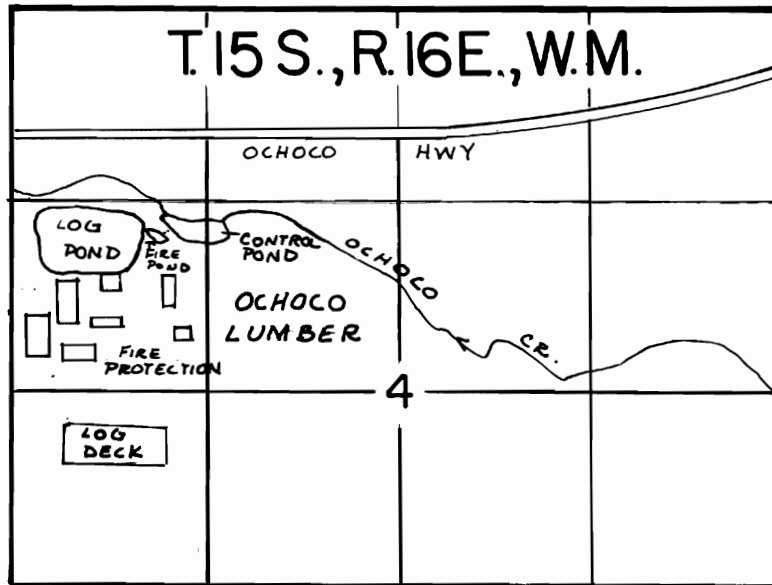

SCALE: 1"=1320'

## FINAL PROOF SURVEY UNDER

Transfer 5631

Application 68342 Permit 49824

IN NAME OF

### OCHOCO IRRIGATION DISTRICT

Surveyed Dec. 11, 1985, by L. OLSON