


T. 15., R. 12 E., W.M.

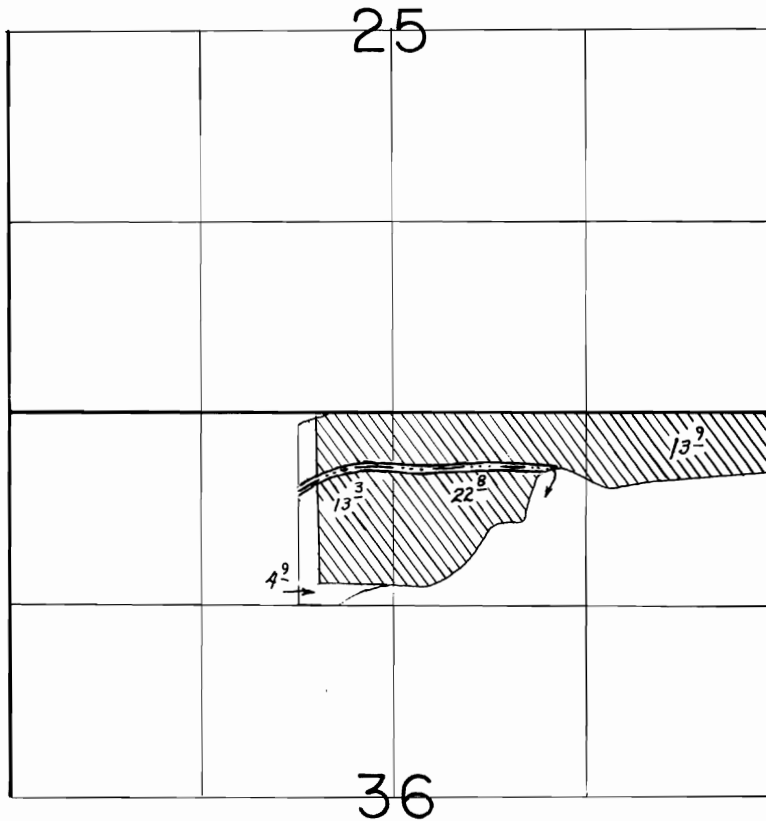

SCALE: 1" = 1320'

**FINAL PROOF SURVEY**  
UNDER

Transfer No. 5633  
Application No. .... Permit No. ....  
IN NAME OF

...ROBERT W. & KATHLEEN OLSON

Surveyed Aug. 10... 1987., by V.L. CHURCH.....

2/8/88 GUB  
41065-472-264  
Revised 1/31/89 LMT