


T-5648

RECEIVED

MAY 24 1985

WATER RESOURCES DEPT
SALEM, OREGON

18

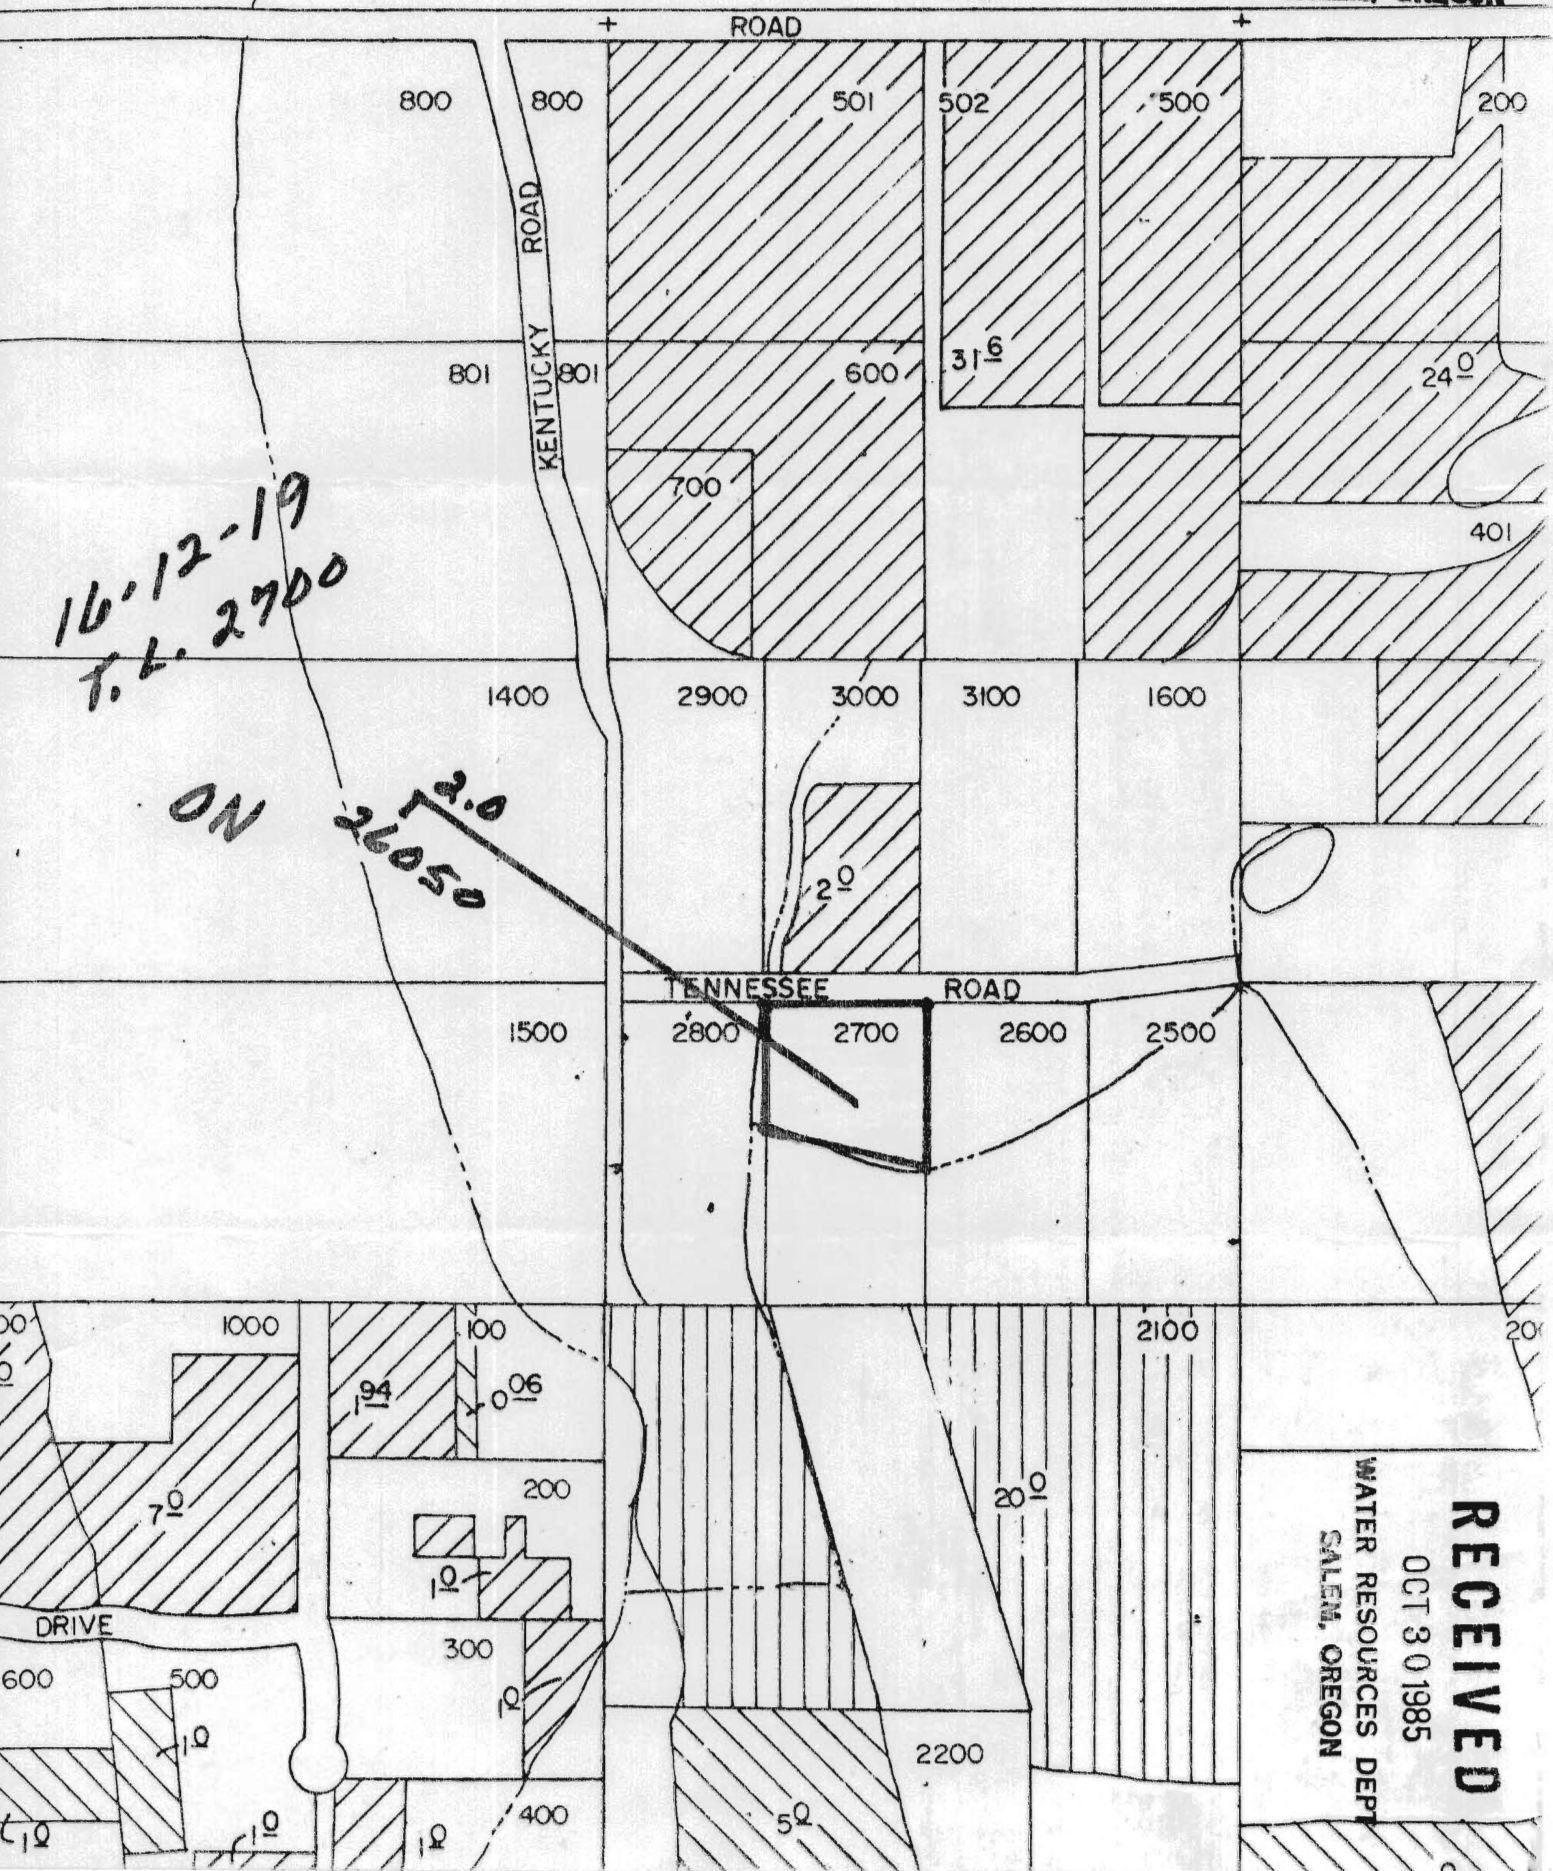

RECEIVED
OCT 30 1985
WATER RESOURCES DEPT
SALEM, OREGON