


T. 14 S., R. 12 E., W.M.

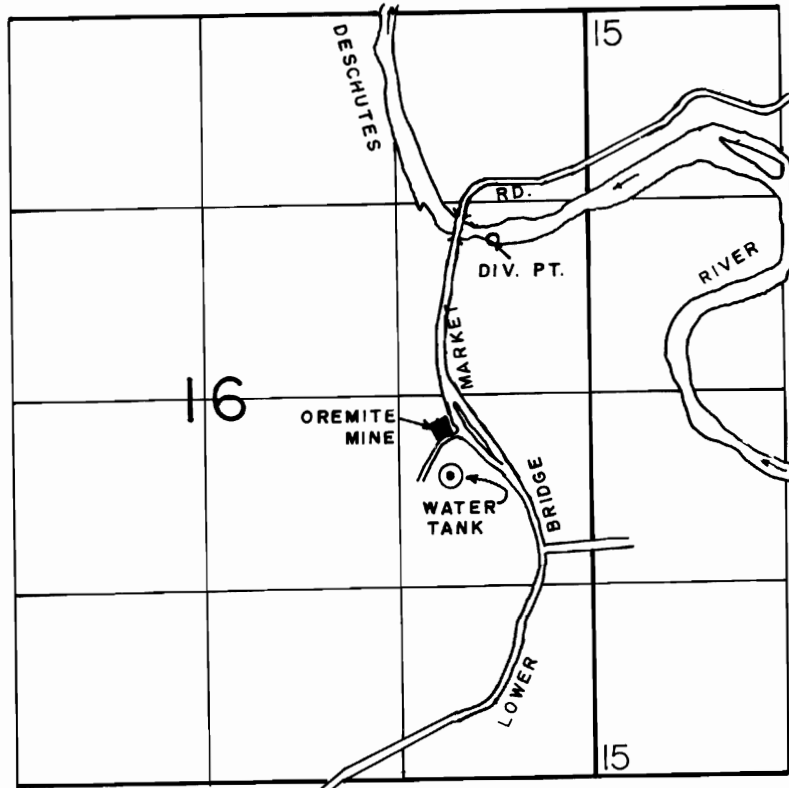

DIV. PT. LOC.: 1570' S. & 650' W. FROM NE COR. SEC. 16.

SCALE: 1" = 1320'

**FINAL PROOF SURVEY
UNDER**

TRANSFER NO. 5647

No. Permit No.

IN NAME OF

FRED GUNZNER

Surveyed AUG. 21, 1991, by B. W. BISHOP...