


T-5656

EXHIBIT "B" T39S R1E W.M.

RECEIVED

JUN 7 1985

WATER RESOURCES DEPT
SALEM, OREGON

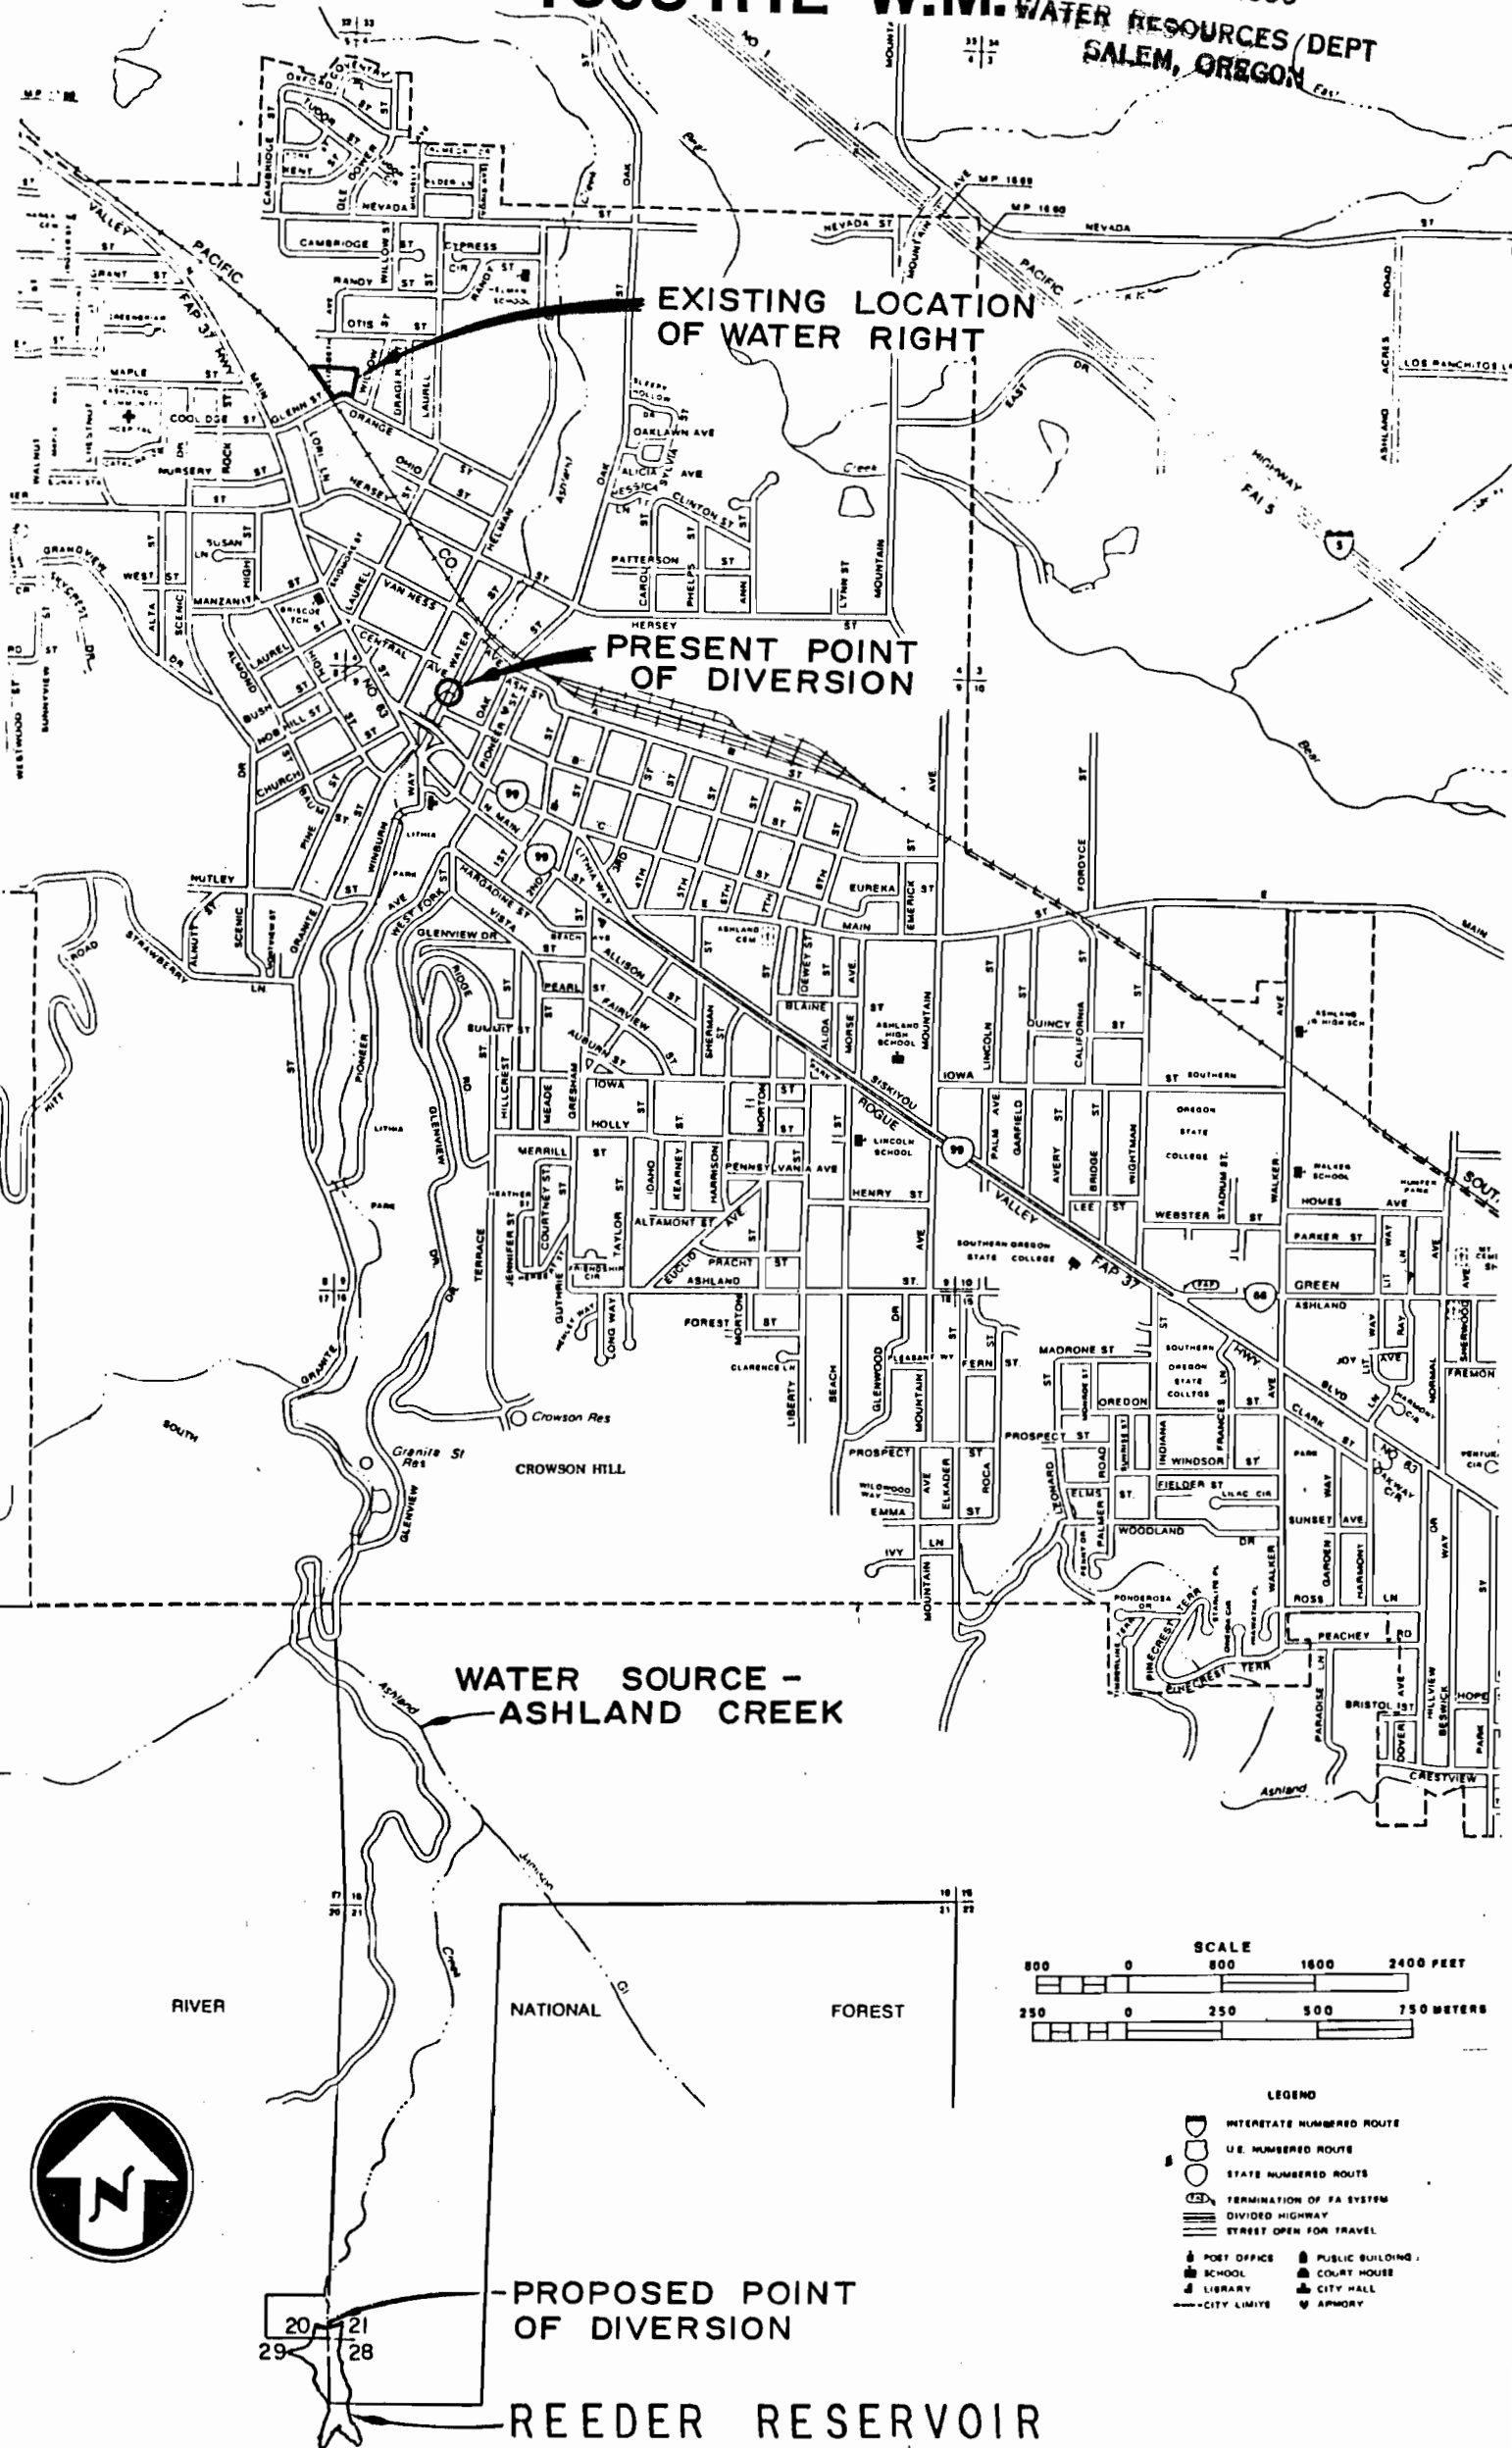


EXISTING LOCATION
OF WATER RIGHT

PRESENT POINT
OF DIVERSION

WATER SOURCE -
ASHLAND CREEK

PROPOSED POINT
OF DIVERSION

REEDER RESERVOIR

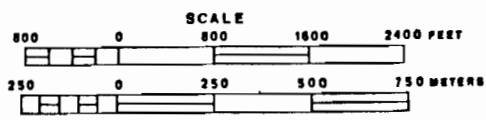

- LEGEND
- INTERSTATE NUMBERED ROUTE
 - U.S. NUMBERED ROUTE
 - STATE NUMBERED ROUTES
 - TERMINATION OF FA SYSTEM
 - DIVIDED HIGHWAY
 - STREET OPEN FOR TRAVEL
 - POST OFFICE
 - SCHOOL
 - LIBRARY
 - CITY HALL
 - PUBLIC BUILDING
 - COURT HOUSE
 - CITY LIMITS
 - ARMORY

