


T.3S., R.4W., W.M.

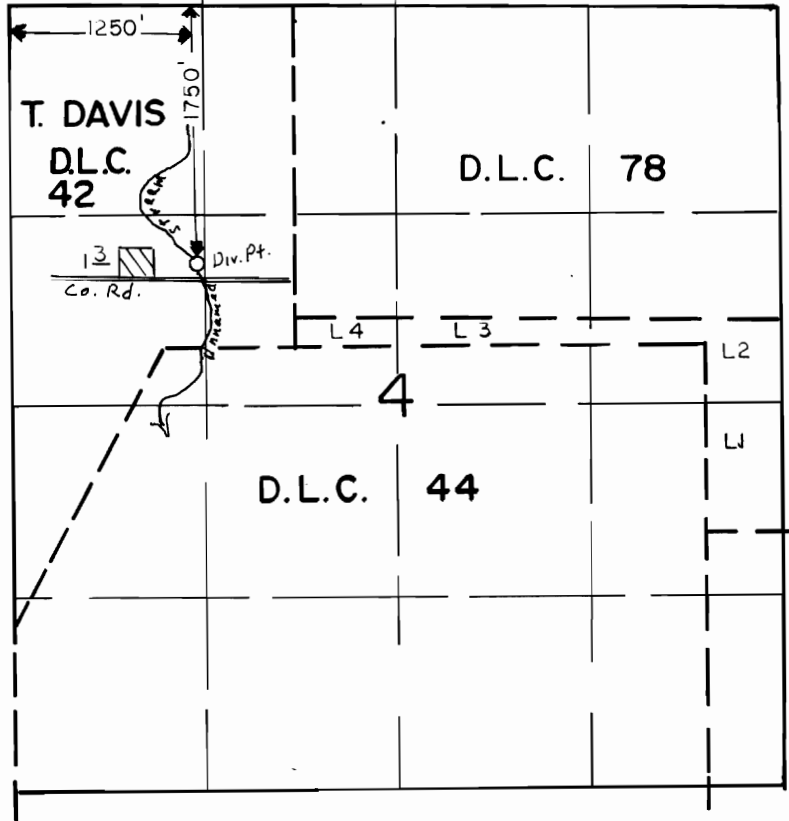

SCALE: 1"=1320'

FINAL PROOF SURVEY
UNDER

Transfer No 5657

Application No. Permit No.

IN NAME OF

.....**SIMON NAGELY**.....

Surveyed **AUG 5**..... 1987..... by **B. W. BISHOP**.....