


T. 40 S., R. 8 W., W.M.

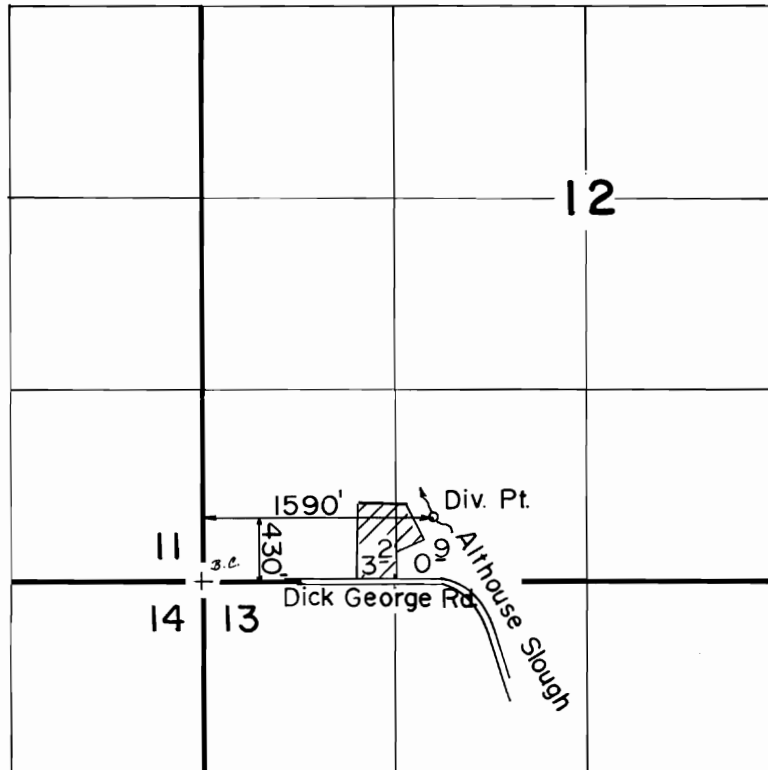

Scale: 1" = 1320'

FINAL PROOF SURVEY
UNDER

TRANSFER NO. 5677

Application No. Permit No.

IN NAME OF

CAROLYN UNDERHILL & SUSAN BROBST

Surveyed APR. 16, 1986, by B. S. JAMES