
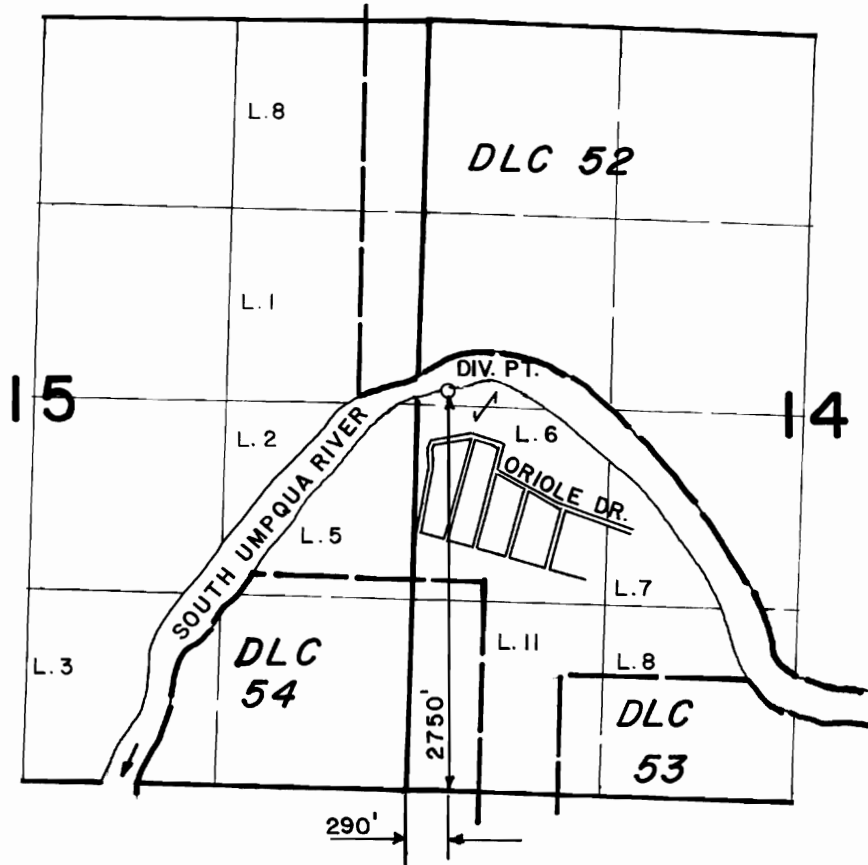


T. 27S., R. 6 W., W. M.

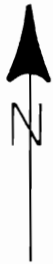

SCALE: 4" = 1 MILE

**FINAL PROOF SURVEY**  
UNDER

TRANSFER NO. 5687

IN NAME OF

**CHARLES H. GOE**

Surveyed OCT. 27, 1987, by J.M. SCHMORDE.