

T.5N., R.28E., W.M.

RECEIVED

SEP 05 1985


RECEIVED

SEP 11 1985


WATER RESOURCES DEPT
SALEM, OREGON

WATER RESOURCES DEPT
SALEM, OREGON

T-5702

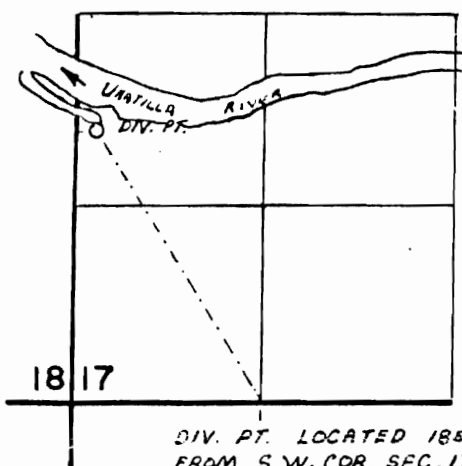

DIV. PT. LOCATED 1850' NORTH AND 150' EAST
FROM S.W. COR. SEC. 17

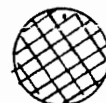

From



To

SCALE: 1" = 1320'

