


T.L. 1300  
C-26508  
8/5/1900

# SECTION 25 T.16S. R.11 E. W.M.

RECEIVED  
SEP 18 1985  
WATER RESOURCES DEPT  
SALEM, OREGON

1" = 400'

T-5704

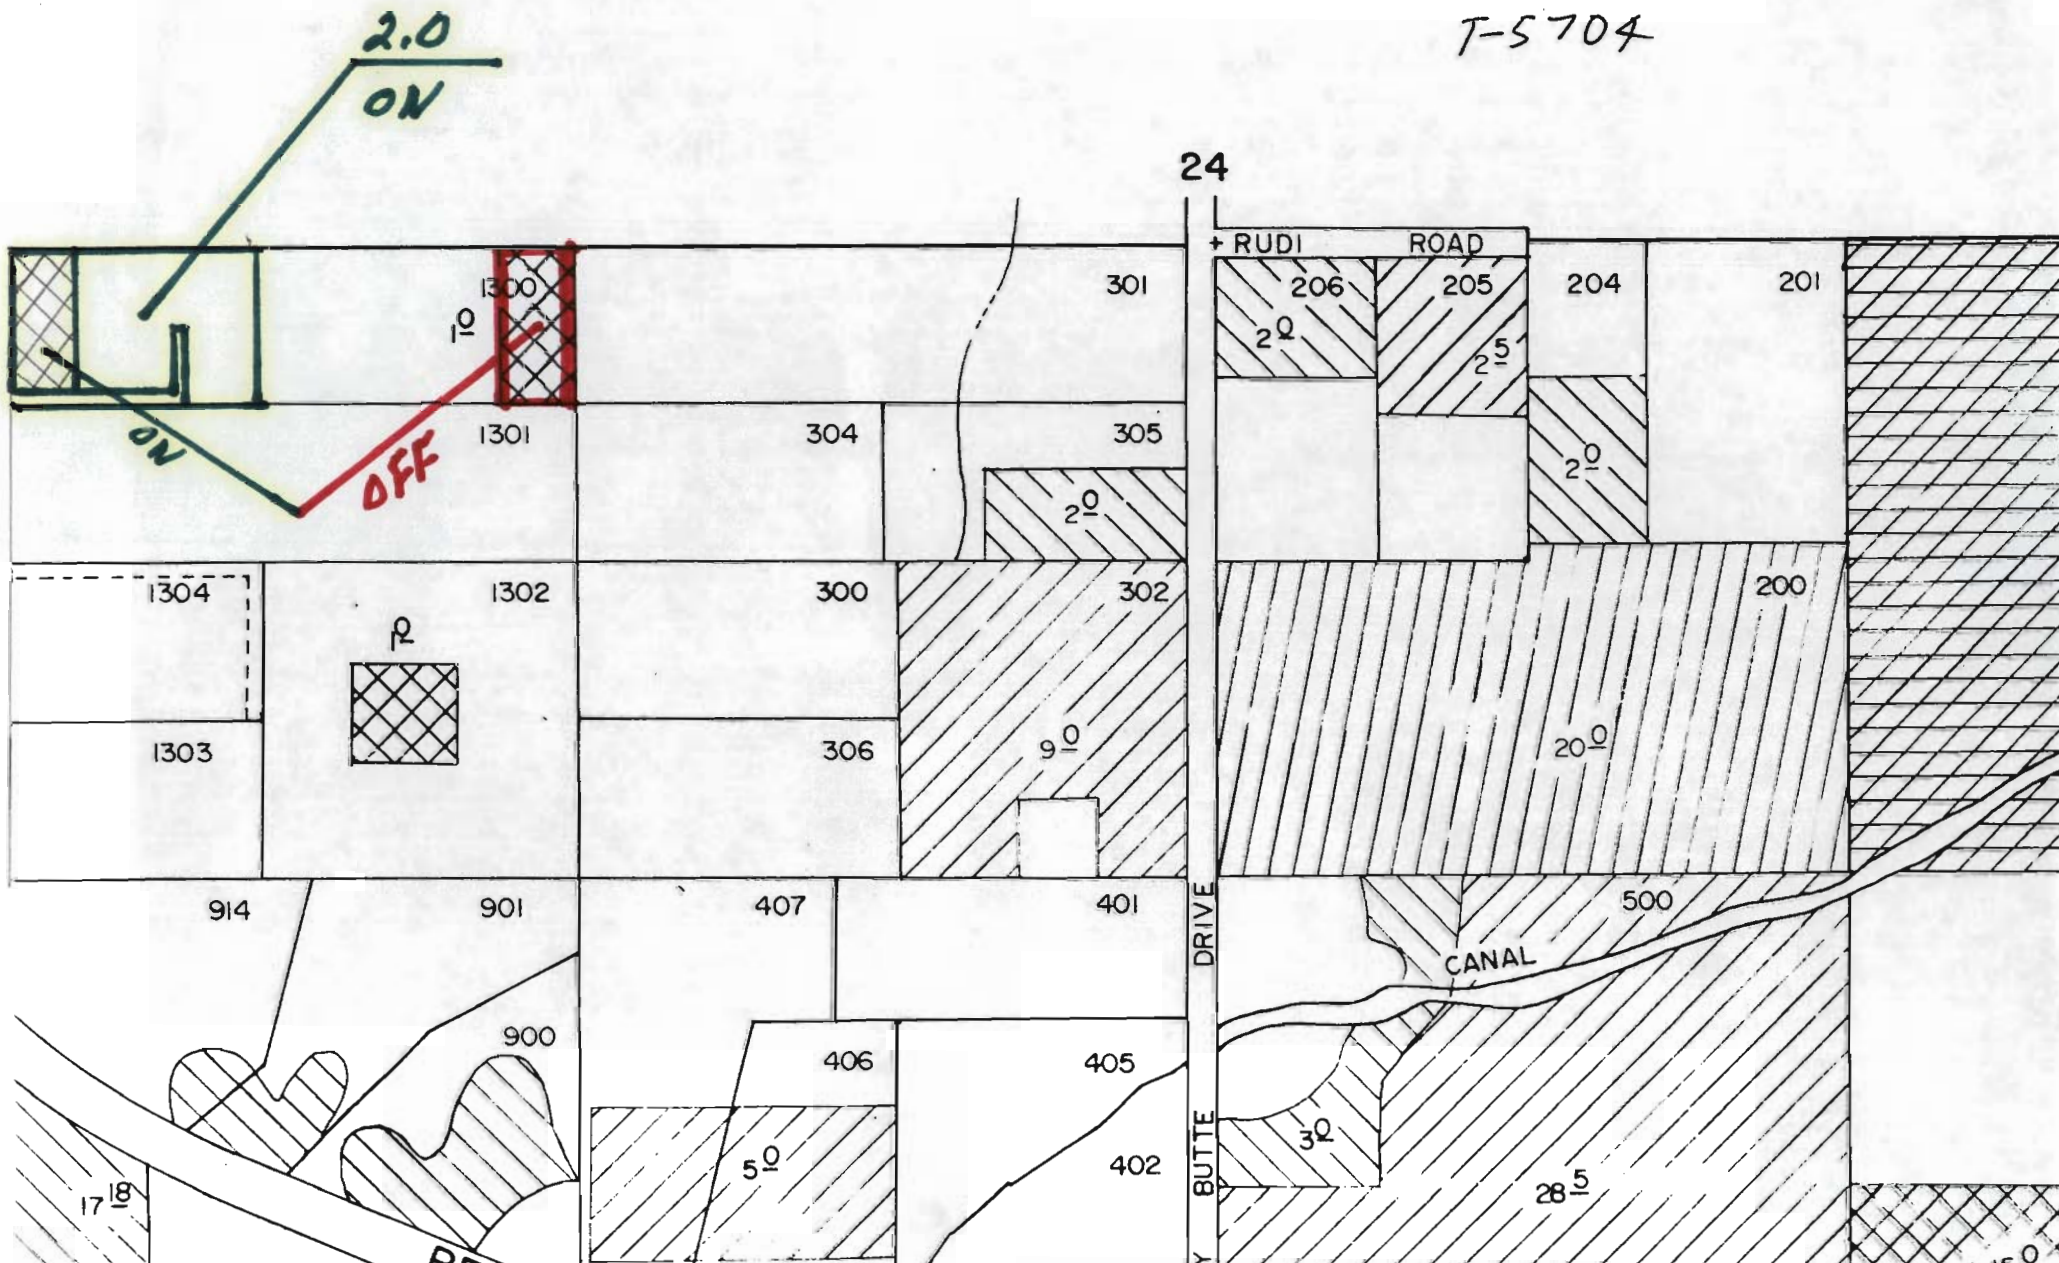

SECTION 34 T.16S. R.11E. W.M.

RECEIVED

SEP 13 1985

WATER RESOURCES DEPT  
SALEM, OREGON

1" = 400'

T.L. 402  
8/5/1900  
2.0 - OFF  
C-26508

T-5704

27

