



**RECEIVED**

OCT - 7 1985

WATER RESOURCES DEPT  
SALEM, OREGON


T3S, R45E, W.M.

1" = 1320'

**RECEIVED**

OCT 10 1985

WATER RESOURCES DEPT  
SALEM, OREGON

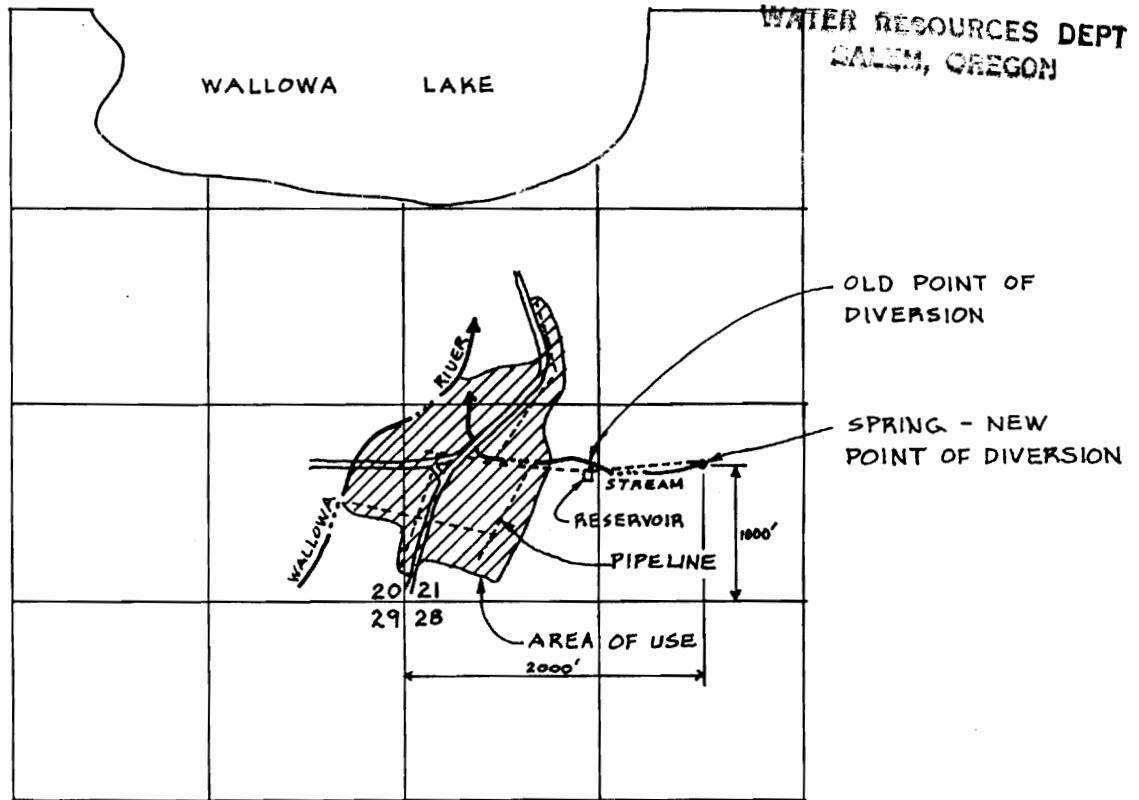

MAP FOR CHANGE IN POINT OF DIVERSION  
FOR  
CHIEF JOSEPH RESORT WATER DISTRICT  
WITH  
WATER RIGHT PERMIT NO. 17948

BASIS OF MAP: FINAL PROOF SURVEY MAP Dated 10-18-55