


T. 36 S., R. 1 W., W. M.

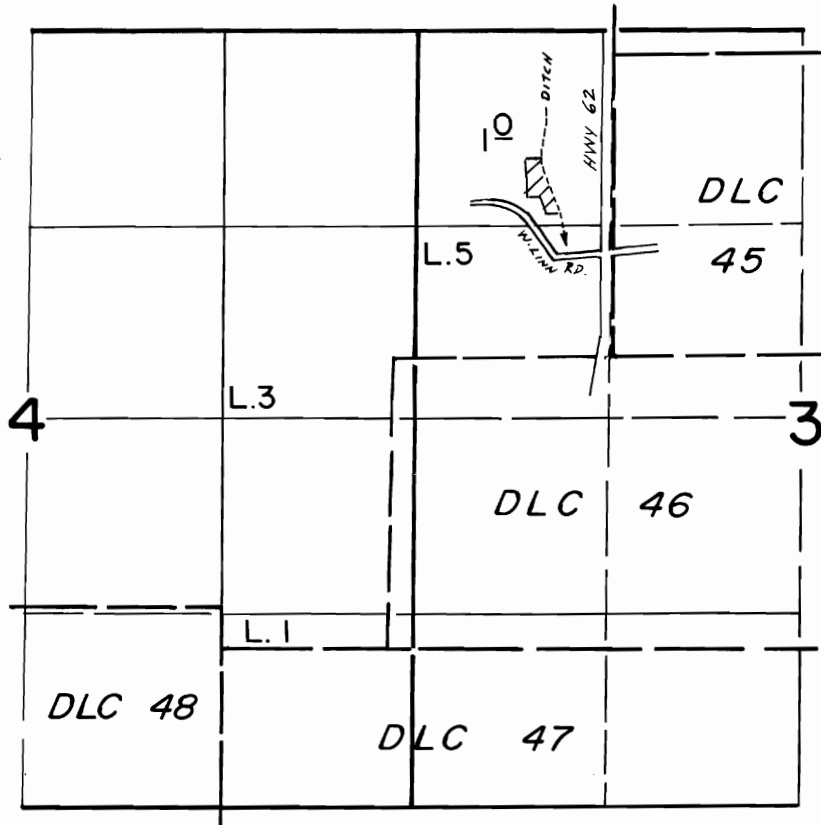

Scale: 1" = 1320'

FINAL PROOF SURVEY UNDER

Transfer No. 5727

Application No. Permit No.

IN NAME OF

..... M. LAVAR HANSON

Surveyed April 25, 1989, by B.S. JAMES