
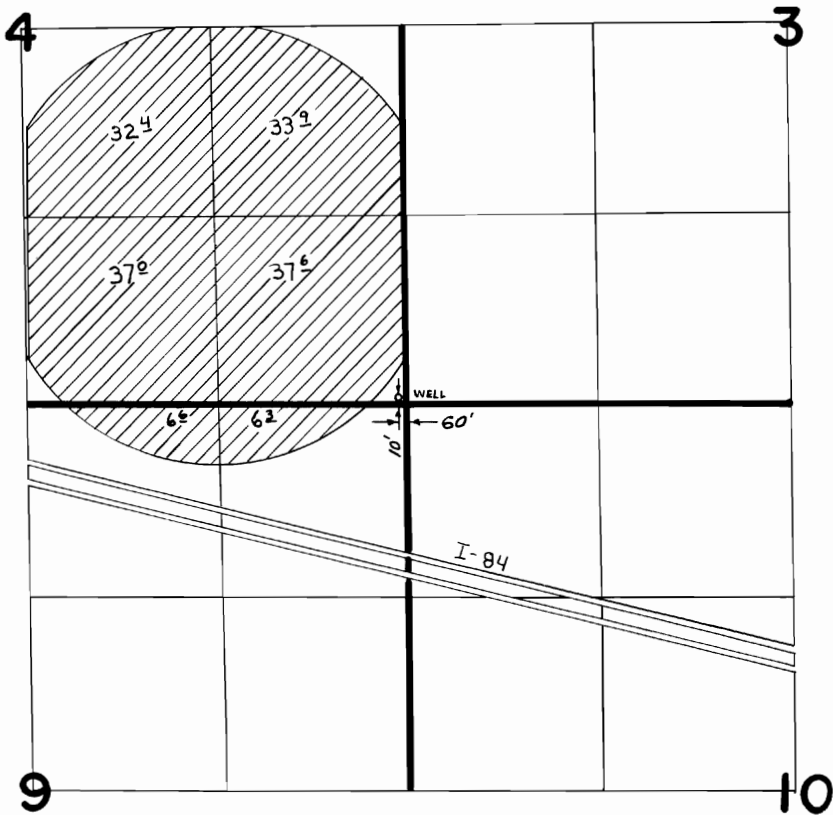


# T. 3 N. R. 29 E. W.M.

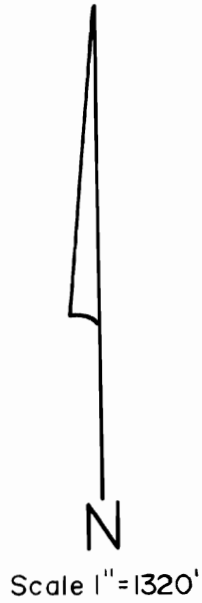

## FINAL PROOF SURVEY UNDER

TRANSFER 5734

IN NAME OF

**STEVE MILLS**

Surveyed Nov. 12, 1986, by V. Church