


T.1S. R.4W. W.M.

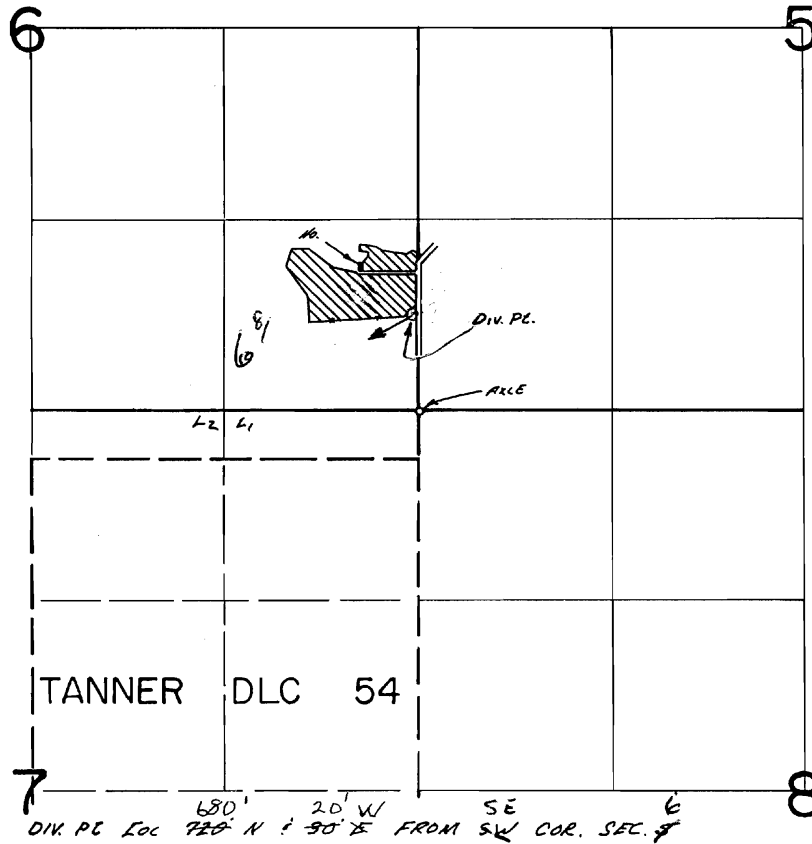

FINAL PROOF SURVEY UNDER

Transfer No. ⁵⁷⁴⁵ ~~2588~~
 Application No. _____ Permit No. _____
 IN NAME OF

ROLLO L. KINTZ

Surveyed ^{7/24/88} ~~Oct 2~~ 1974, by ^{T M WARREN} ~~R. G. MUCKEN~~