


NW SW	10.7	1.5
NE SW	14.3	11.2
NE SW	-0-	
SE SW	-0-	12.3
	25.0	25.0

RECEIVED
 FEB 11 1986
 WATER RESOURCES DEPT
 SALEM, OREGON

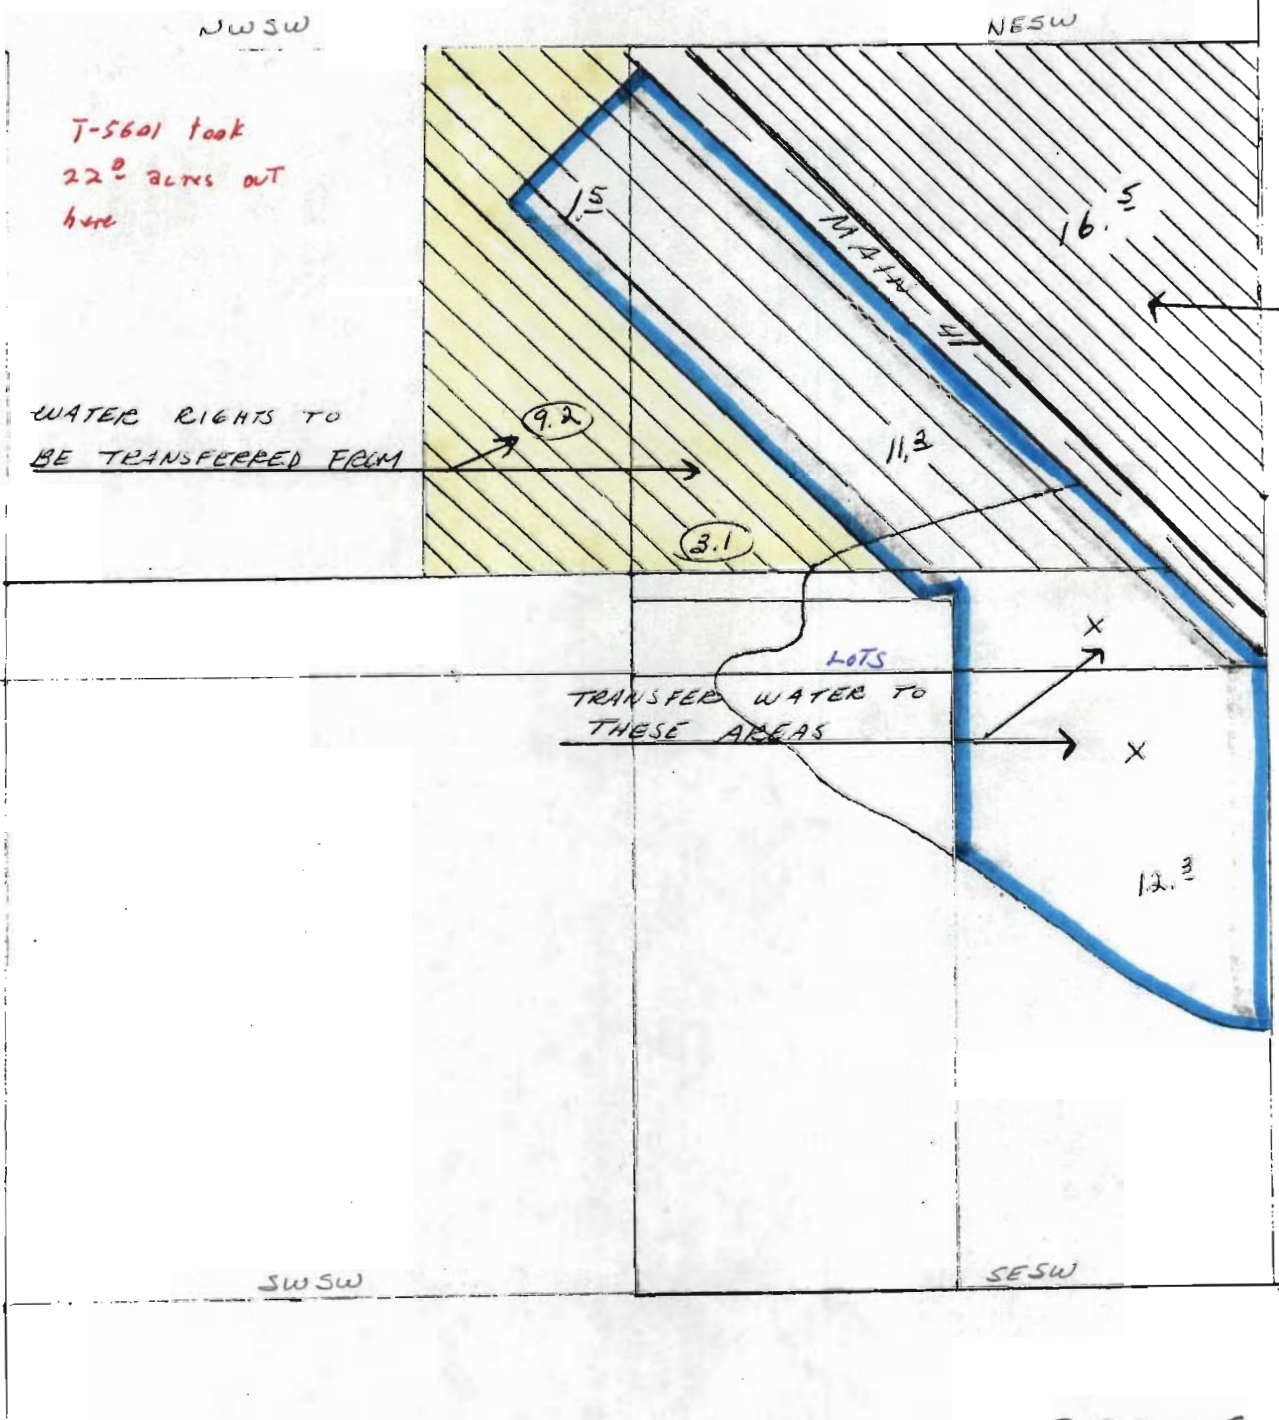

T-5755

APPROVED Errol W. Oldh
 11-7-1985

GARY DINKEL RENTS
 PAUL & CAROLE HERB OWN

PROPOSED WATER RIGHT TRANSFER
 SEC 17, TWP 12, RANGE 13

Carl JOHNSON

RECEIVED

FEB 11 1986

WATER RESOURCES DEPT
SALEM, OREGON


Marylyn

17 R

TRANSFERRED OUT
1985
22.0

T-5774
0.2 ac
OUT

TRANSFERRED
OUT 1984 & 1985

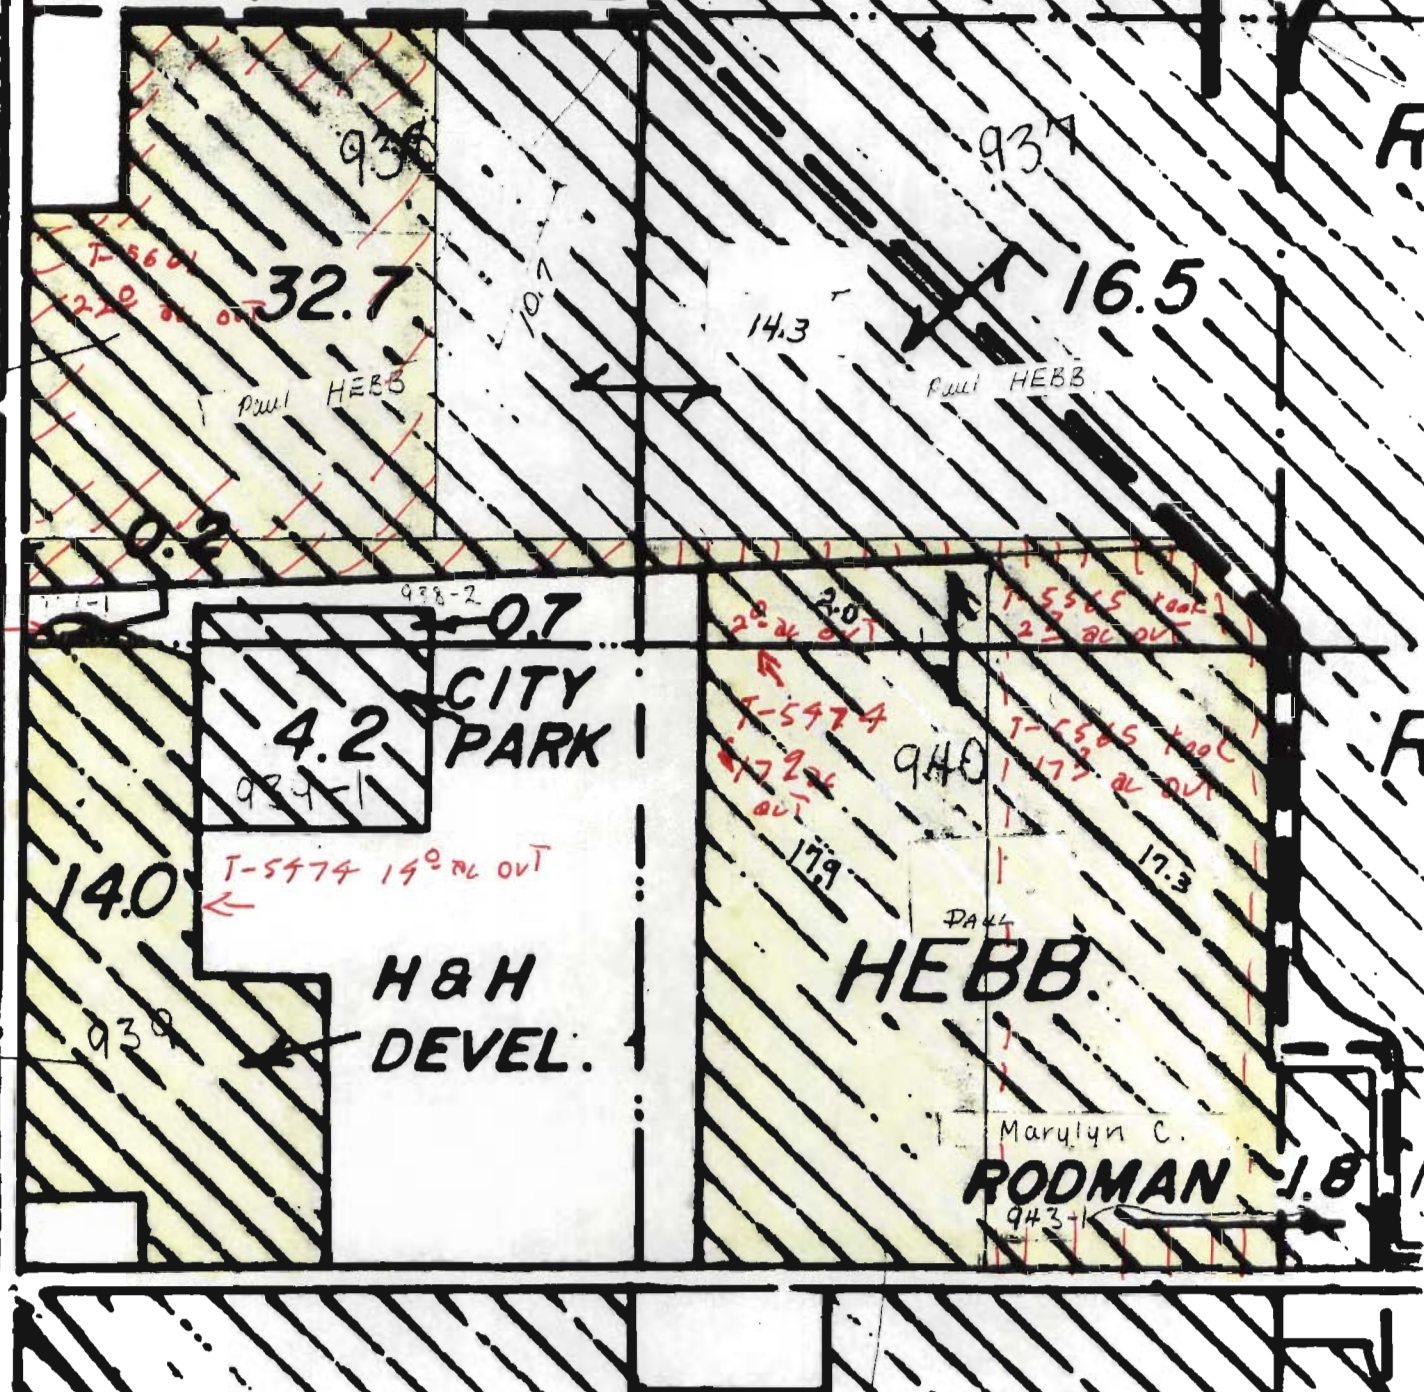

HEBB TO WINKEL
TRANSFERRED OUT
1984 & 1985

T-5755

SEC 17, TWP 12, RANGE 13

PREVIOUSLY TRANSFER OUT