

T-5760


RECEIVED

FEB 19 1986


WATER RESOURCES DEPT
SALEM, OREGON

SECTION 11, T.17S., R.12EWM
SW 1/4 - NE 1/4

SCALE 1" = 200'

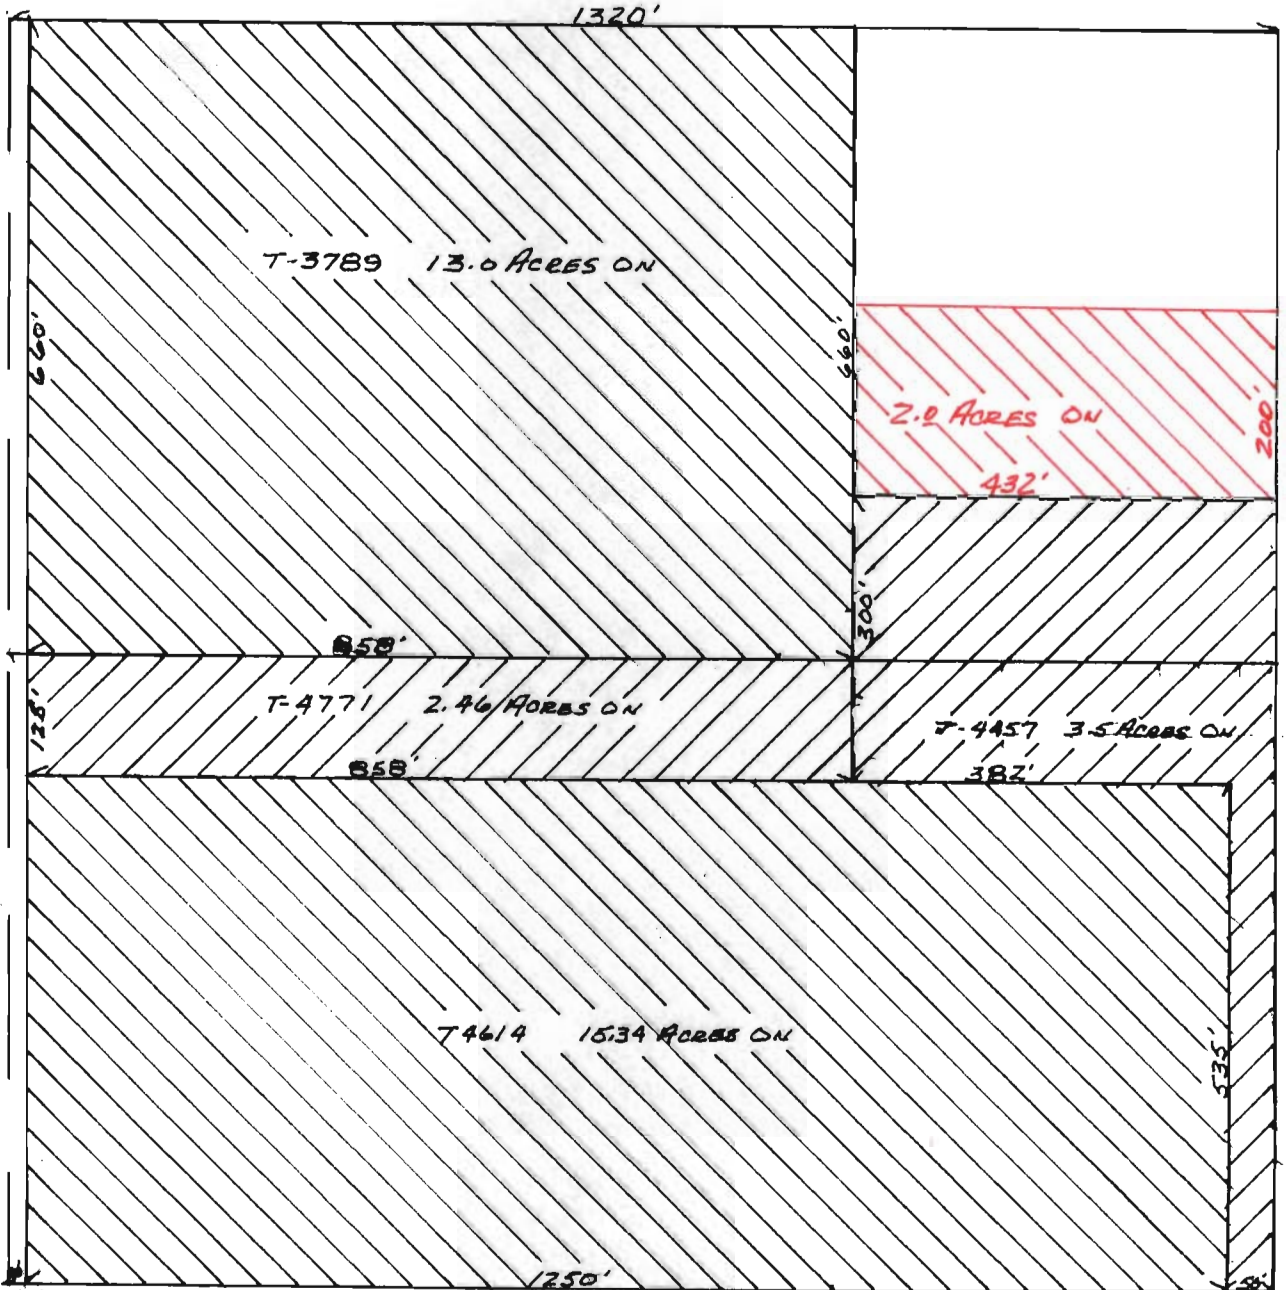

T-5760

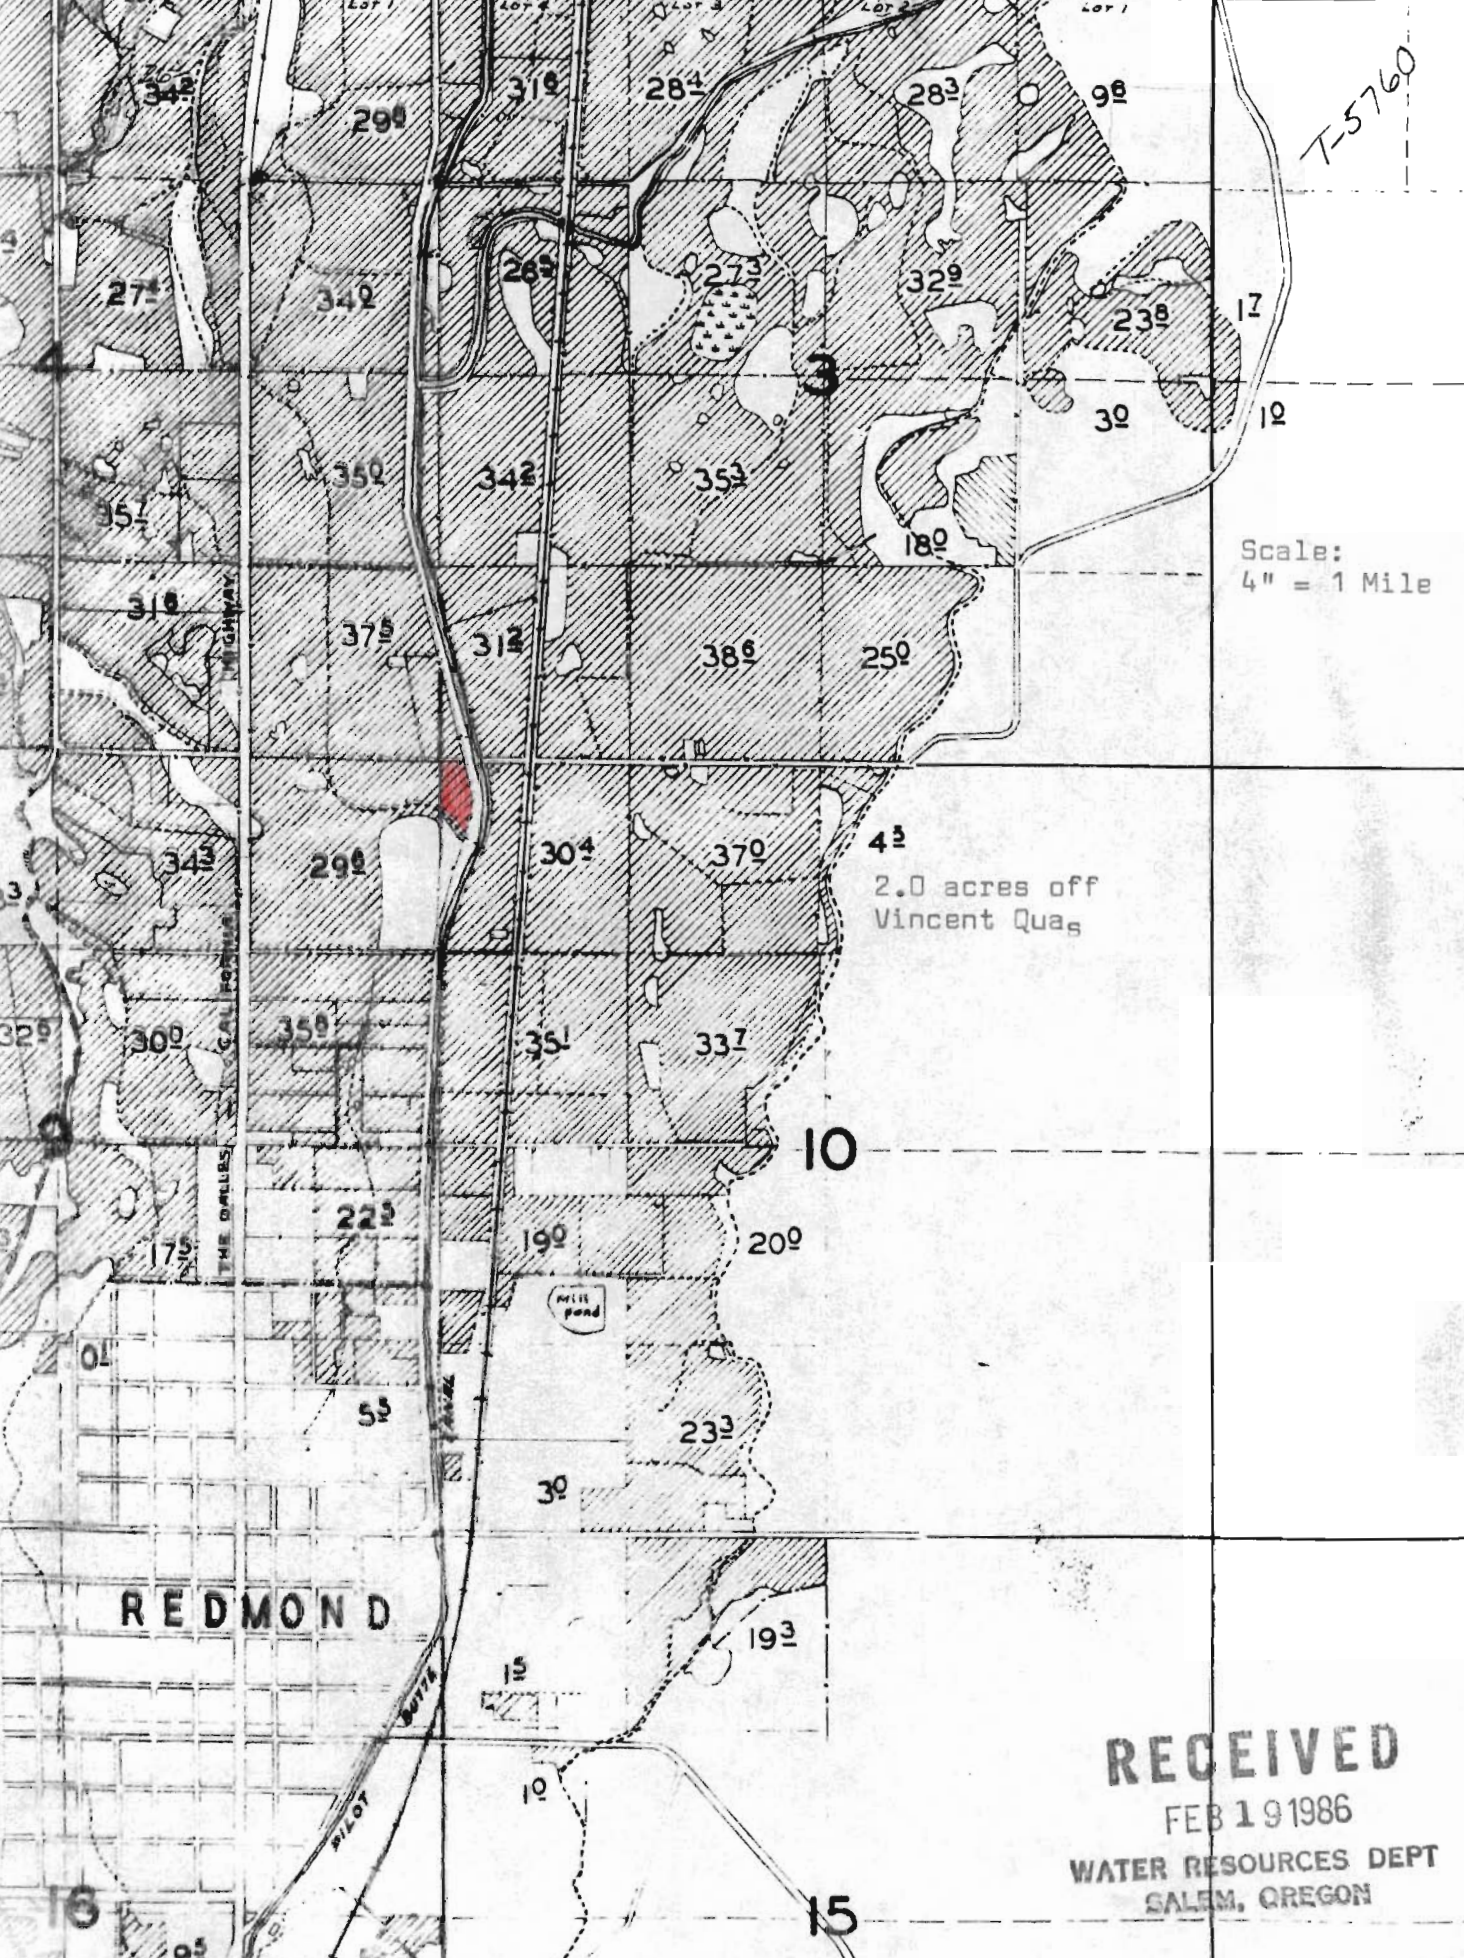

Scale:
4" = 1 Mile

2.0 acres off
Vincent Quas

REDMOND

RECEIVED
FEB 19 1986
WATER RESOURCES DEPT
SALEM, OREGON