


T. 3 N., R. 28, E. W. M.

RECEIVED

FEB 18 1987

WATER RESOURCES DEPT.  
SALEM, OREGON


"From"

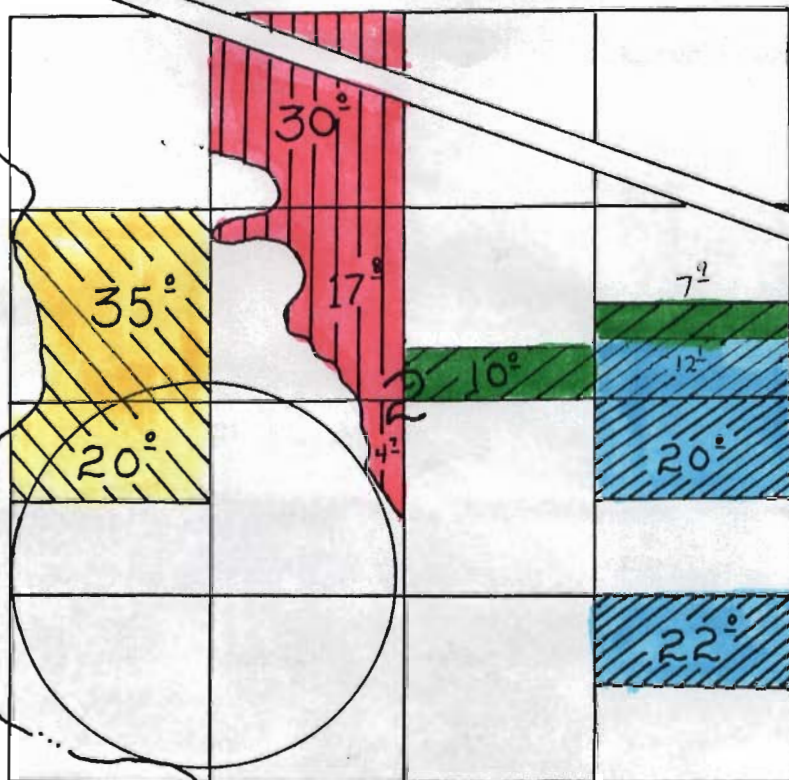


T-5763

- Westland vested 55.0 Acres
- Westland Supp. Decree 52.5 Acres
- Courtney vested 17.9 Acres
- Courtney vested 54.1 Acres

"To"

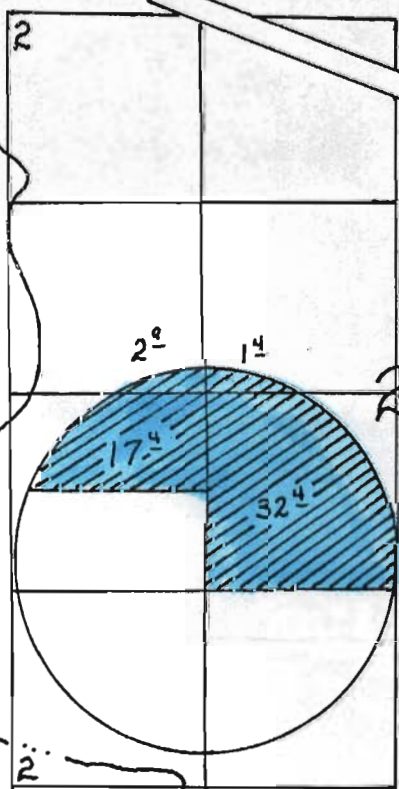

"To"

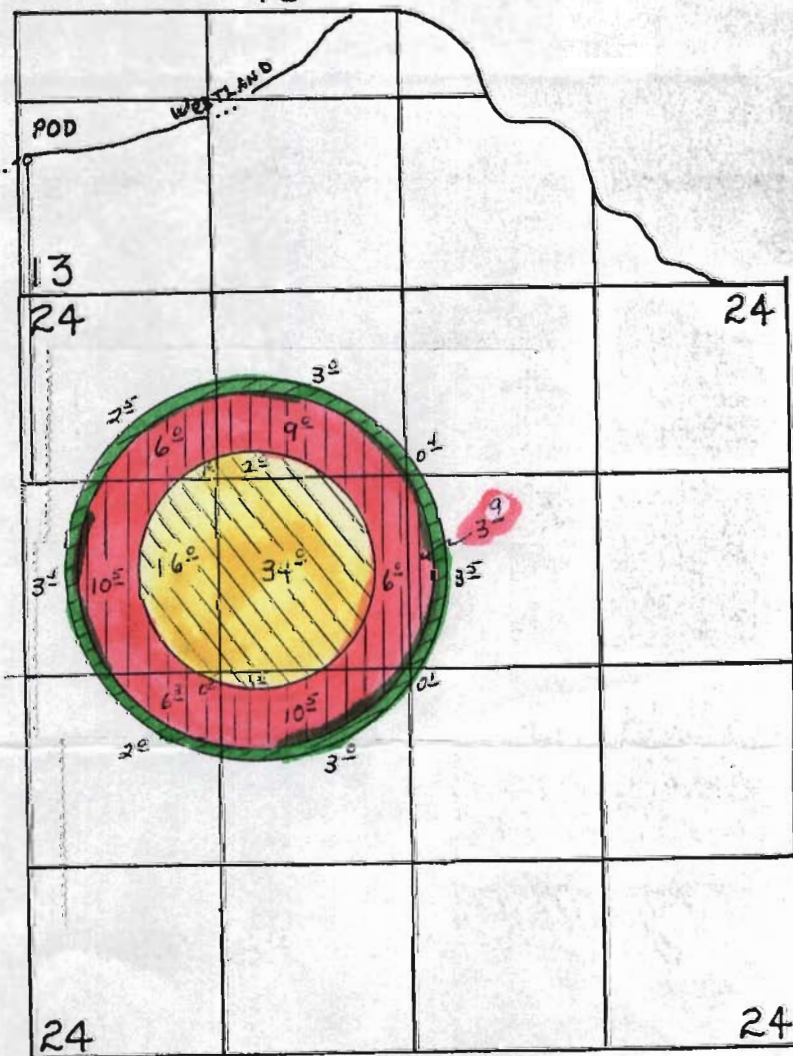

Scale: 1" = 1320'