
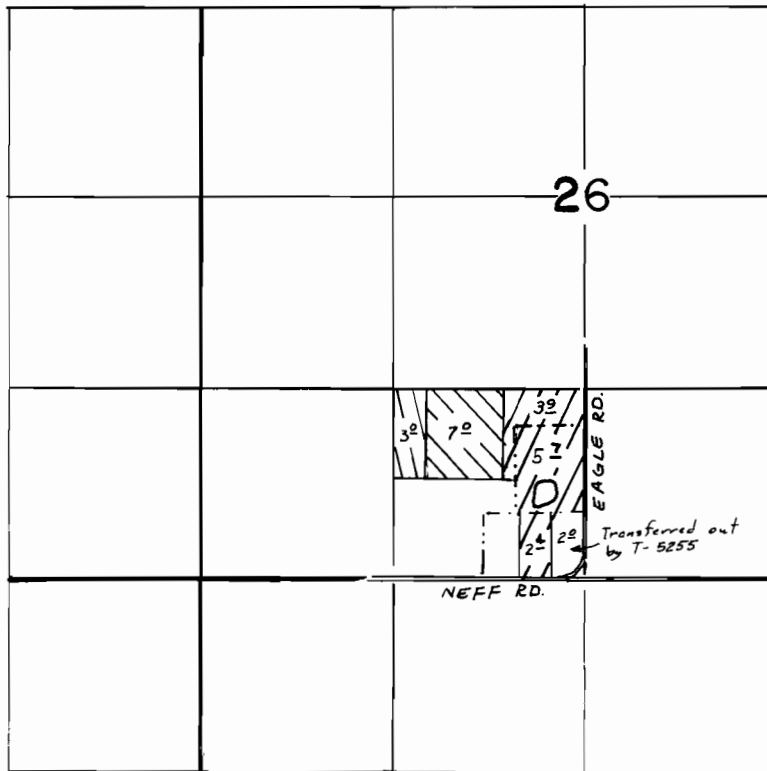
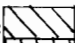


# T.17S.,R.12E.,W.M.

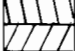

SCALE: 1" = 1320'

## FINAL PROOF SURVEY UNDER

Transfer M-140c  1 of 4  
 2848  
 Cert. 29052 

IN NAME OF

..... ROBT. H. FOLEY .....

Surveyed JUNE 24 19.85., by L. OLSON.....