



T. 4N., R. 28E., W. M.

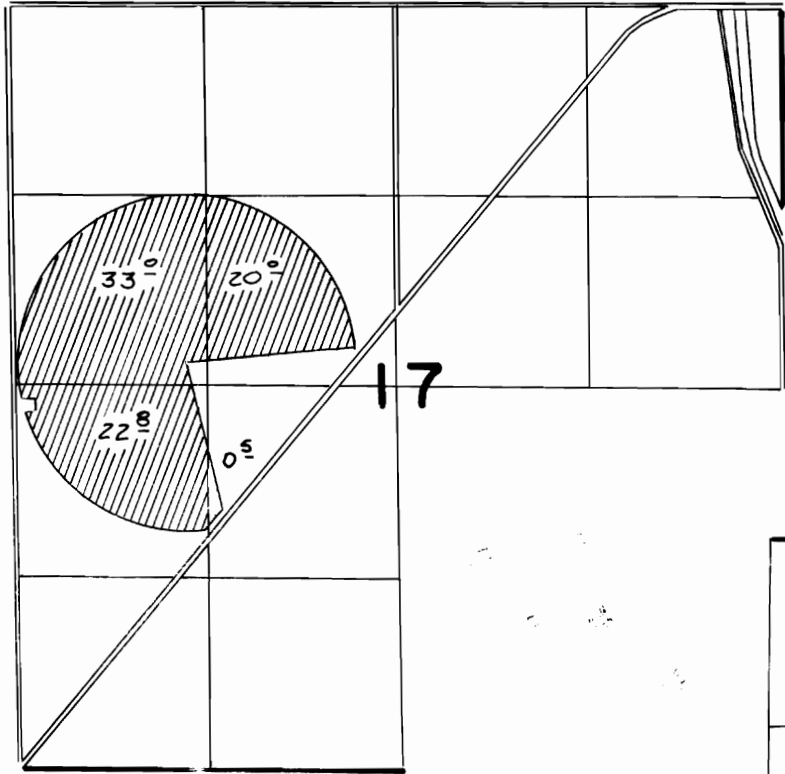

T. 3N., R. 29E., W.M.

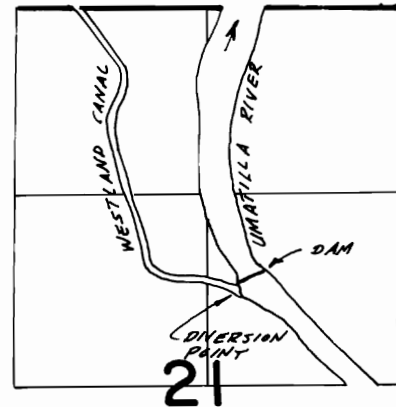

75⁸

DIVERSION POINT LOCATED N. 76° 45' 56" E. 2913.19' FROM W. 1/4 COR SEC. 21

FINAL PROOF SURVEY
UNDER

TRANSFER 5766
IN NAME OF

.....**HOWARD GASS**.....

Surveyed Aug. 21..... 1986., by V. L. Church.....